

CORNER RECORD

Agency Index CR-25-438


Document Number _____

City of STOCKTON County of SAN JOAQUIN, California

Brief Legal Description MONUMENT AT THE INTERSECTION OF S SACRAMENTO ST AND E SEVENTH ST

CORNER TYPE

COORDINATES (Optional)

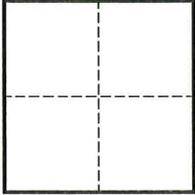

- Government Corner
- Meander
- Rancho
- Control
- Property
- Other

Date of Survey MAY 13, 2025

N. _____ E. _____

Elevation _____

Units Metric U.S. Survey Foot

Horizontal Datum _____

Zone _____ Epoch Date _____

Vertical Datum _____

Complies with Public Resources Code §§8801-8819

Complies with Public Resources Code §§8890-8902

PLS Act Ref.: 8765(d) 8771 8773 Other:

Corner/Monument: Left as found Established Rebuilt Pre-Construction
 Found and tagged Reestablished Referenced Post-Construction

Narrative of corner identified and monument as found, set, reset, replaced, or removed:

See sheet #2 for description(s):

FOUND 1/2" REBAR WITH PUNCH, IN MONUMENT WELL.

MONUMENT WAS REFERENCED PRIOR TO THE START OF CONSTRUCTION PROJECT IN THE VICINITY BY WEST VALLEY CONSTRUCTION COMPANY.

SURVEYOR'S STATEMENT

This Corner Record was prepared by me or under my direction in conformance with

the Professional Land Surveyors' Act on JUNE 3, 2025

Signed [Signature] P.L.S. or R.C.E. No. 9592



COUNTY SURVEYOR'S STATEMENT

This Corner Record was received December 4, 2025

and examined and filed December 18, 2025


Signed James E. Hart P.L.S. or R.C.E. No. 8657

Title County Surveyor



County Surveyor's Comment

[Empty dashed box for County Surveyor's Comment]

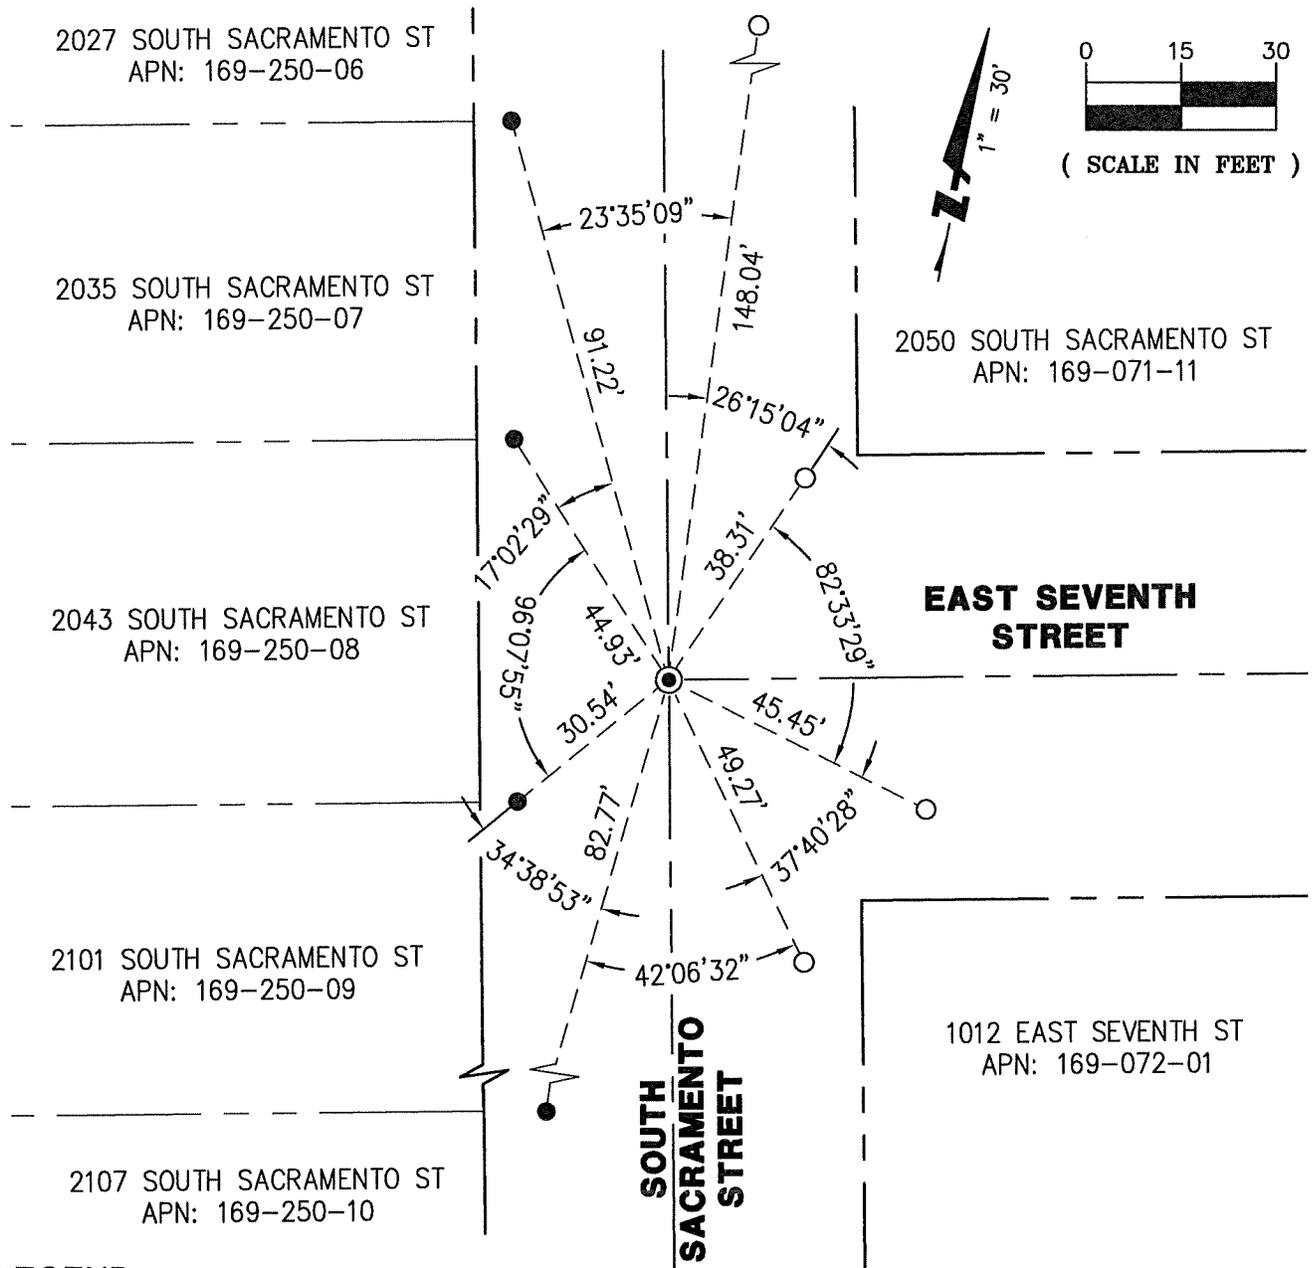

LEGEND

- ⊙ FOUND 1/2" REBAR WITH PUNCH, IN MONUMENT WELL, IN LIEU OF 3/4" IRON PIN IN MONUMENT WELL PER VOLUME 19 OF MAPS AND PLATS AT PAGE 49, SAN JOAQUIN COUNTY RECORDS
- FOUND 1" BRASS PLUG STAMPED "PLS 8489", PER CR-24-216, SAN JOAQUIN COUNTY SURVEYOR'S RECORDS
- SET MAG NAIL & WASHER IN TOP OF CONCRETE ROLLED CURB
- CR CORNER RECORD



1730 N. FIRST STREET
 SUITE 600
 SAN JOSE, CA 95112
 (408) 467-9100
 www.bkf.com

SUBJECT **PRE-CONSTRUCTION CORNER RECORD**
SOUTH SACRAMENTO STREET AND EAST SEVENTH STREET
 JOB NO. **20191483 - MON PRESERVATION**
 BY **GA** APPR. **RDV** DATE **06-03-2025**

16:20191483-0001_PRESERVATION-410_SOUTH SACRAMENTO STREET-410_EAST SEVENTH STREET-2025