

# CORNER RECORD

Agency Index CR-25-440


Document Number \_\_\_\_\_

City of STOCKTON County of SAN JOAQUIN, California

Brief Legal Description MONUMENT AT THE INTERSECTION OF SOUTH SACRAMENTO ST AND EAST TENTH ST

### CORNER TYPE

### COORDINATES (Optional)

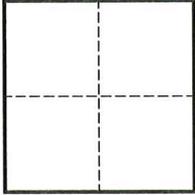

- Government Corner
- Meander
- Rancho
- Control
- Property
- Other

Date of Survey MAY 14, 2025

N. \_\_\_\_\_ E. \_\_\_\_\_

Elevation \_\_\_\_\_

Units  Metric  U.S. Survey Foot

Horizontal Datum \_\_\_\_\_

Zone \_\_\_\_\_ Epoch Date \_\_\_\_\_

Vertical Datum \_\_\_\_\_

Complies with Public Resources Code §§8801-8819

Complies with Public Resources Code §§8890-8902

PLS Act Ref.:  8765(d)  8771  8773  Other:

Corner/  
Monument:  Left as found  Established  Rebuilt  Pre-Construction  
 Found and tagged  Reestablished  Referenced  Post-Construction

Narrative of corner identified and monument as found, set, reset, replaced, or removed:

See sheet #2 for description(s):

FOUND 1/2" REBAR WITH PUNCH, IN MONUMENT WELL.

MONUMENT WAS REFERENCED PRIOR TO THE START OF CONSTRUCTION PROJECT IN THE VICINITY BY WEST VALLEY CONSTRUCTION COMPANY.

### SURVEYOR'S STATEMENT

This Corner Record was prepared by me or under my direction in conformance with

the Professional Land Surveyors' Act on JUNE 3, 2025

Signed [Signature] P.L.S. or R.C.E. No. 9592



### COUNTY SURVEYOR'S STATEMENT

This Corner Record was received December 4, 2025

and examined and filed December 18, 2025


Signed James E Hart P.L.S. or R.C.E. No. 8657

Title County Surveyor



### County Surveyor's Comment

[Empty dashed box for County Surveyor's Comment]

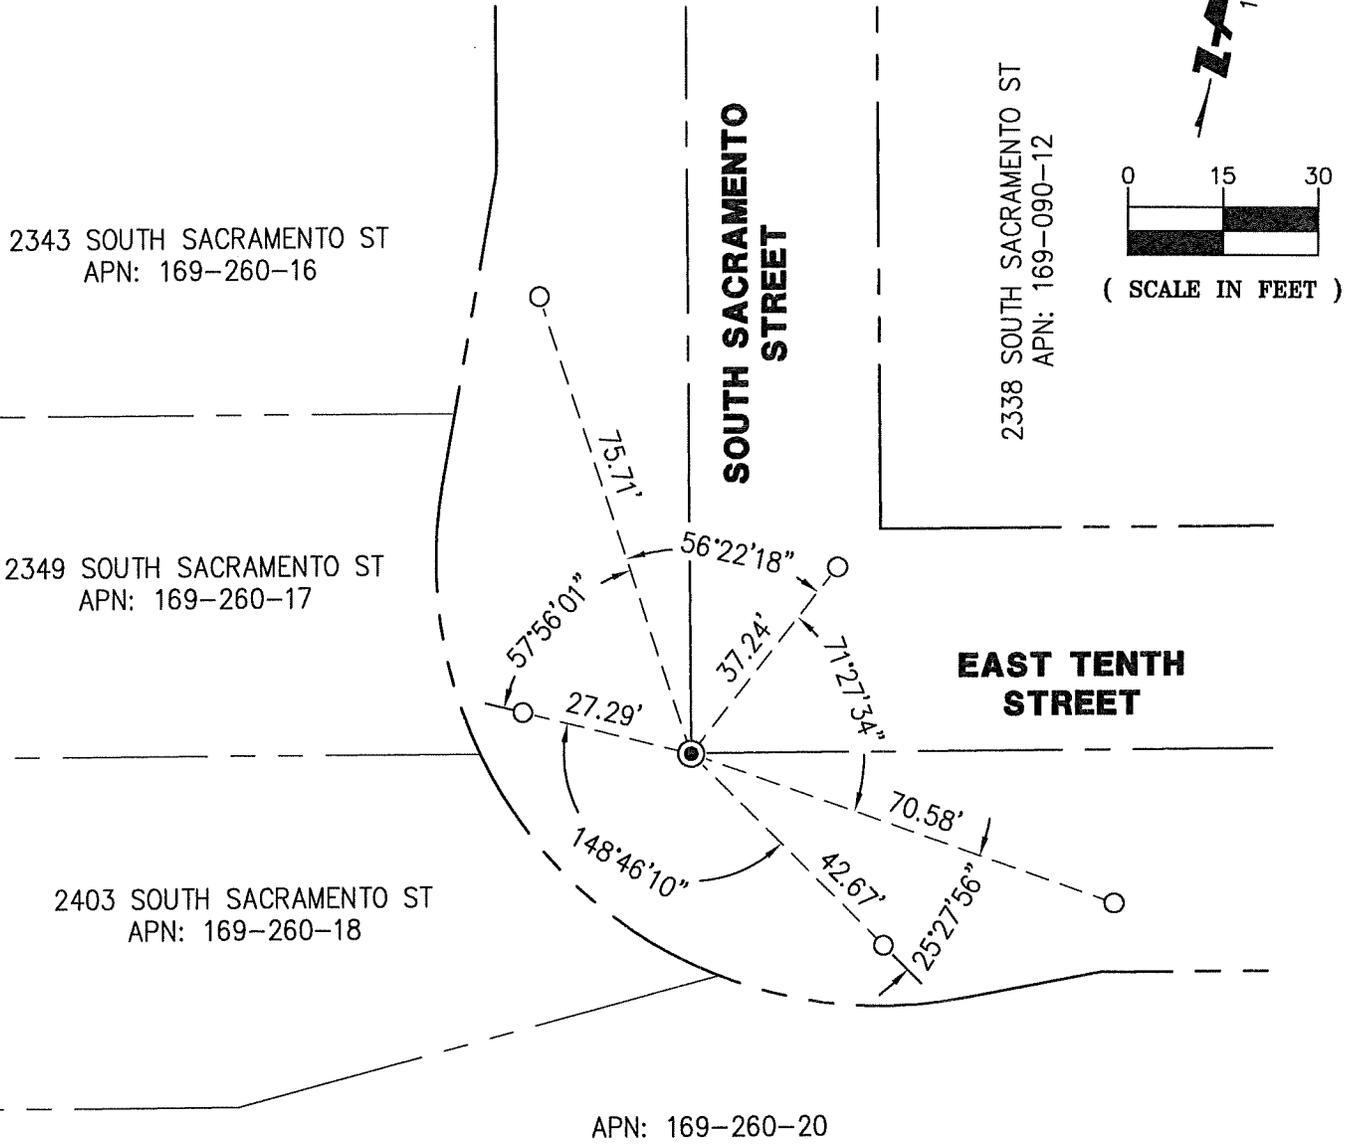

**LEGEND**

- FOUND 1/2" REBAR WITH PUNCH, IN MONUMENT WELL, IN LIEU OF 3/4" IRON PIN IN CAST MONUMENT WELL PER VOLUME 19 OF MAPS AND PLATS AT PAGE 49, SAN JOAQUIN COUNTY RECORDS
- SET MAG NAIL & WASHER IN TOP OF CONCRETE ROLLED CURB

**BKF**  
 1730 N. FIRST STREET  
 SUITE 600  
 SAN JOSE, CA 95112  
 (408) 467-9100  
 www.bkf.com

SUBJECT **PRE-CONSTRUCTION CORNER RECORD**  
**SOUTH SACRAMENTO STREET AND EAST TENTH STREET**

JOB NO. **20191483 - MON PRESERVATION**  
 BY **GA** APPR. **RDV** DATE **06-03-2025**

16 SANJOAQUINCOUNTYRECORDS-481578-2025-FILED-2025-06-03-10:00AM