

CORNER RECORD

Agency Index CR-25-442


Document Number _____

City of Lodi County of San Joaquin, California

Brief Legal Description Property monument at 124 Harvest Lane

CORNER TYPE

COORDINATES (Optional)

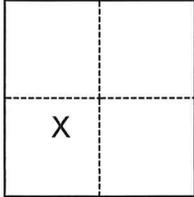

- Government Corner
- Meander
- Rancho
- Control
- Property
- Other

N. _____ E. _____

Elevation _____

Units Metric U.S. Survey Foot

Horizontal Datum _____

Zone _____ Epoch Date _____

Vertical Datum _____

Complies with Public Resources Code §§8801-8819

Complies with Public Resources Code §§8890-8902

Date of Survey July 31, 2025

Section 3, T.3N.,R.6E.
M.D.B.&M.

PLS Act Ref.: 8765(d) 8771 8773 Other:

Corner/Monument: Left as found Established Rebuilt Pre-Construction

Found and tagged Reestablished Referenced Post-Construction

Narrative of corner identified and monument as found, set, reset, replaced, or removed:

See sheet #2 for description(s):

FOUND ONE (1) UNDISTURBED IRON ROD CAPPED "RCE 19638" PER M&P 34-069 AT THE SOUTHEAST CORNER OF ELM STREET AND HARVEST LANE. FOUND THREE (3) NAILS WITH WASHERS, STAMPED "C.O.L. LS 9478" PER CR 25-093. NO BOUNDARY ANALYSIS WAS PERFORMED.

SURVEYOR'S STATEMENT

This Corner Record was prepared by me or under my direction in conformance with the Professional Land Surveyors' Act on 8/28/25

Signed [Signature] P.L.S. or R.C.E. No. 9478



COUNTY SURVEYOR'S STATEMENT

This Corner Record was received October 13, 2025

and examined and filed November 6, 2025

Signed James E Hart P.L.S. or R.C.E. No. 8657


Title County Surveyor

County Surveyor's Comment



LODI WEST
UNIT NO. 1
M&P 31-080


6 7 8 9 10

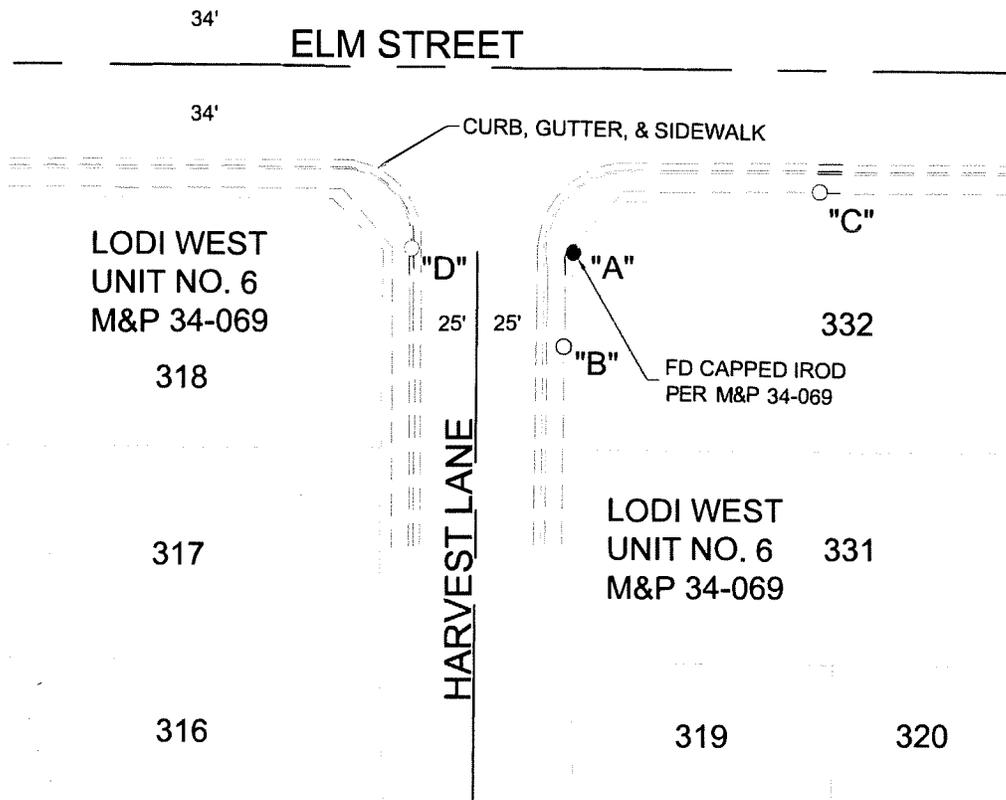

DISTANCE (M) TABLE							
	FD MONUMENT	FROM	DIST	FROM	DIST	FROM	DIST
"A"	FOUND CAPPED IROD STAMPED "RCE 19638"	"B"	24.69'	"C"	66.21'	"D"	42.55'

LEGEND

- FOUND MONUMENT AS NOTED IN TABLE, PER M&P 34-069
- FOUND NAIL AND WASHER
STAMPED "C. O. L. LS 9478"
- DIST DISTANCE
- IROD IRON ROD
- M&P MAPS & PLATS, VOLUME & PAGE,
SAN JOAQUIN COUNTY RECORDS
- S.C.J.R SAN JOAQUIN COUNTY RECORDS
- (M) MEASURED ON THIS SURVEY
- FD FOUND

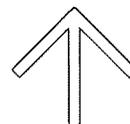

NORTH
SCALE: 1"=50'
2422-CR.DWG