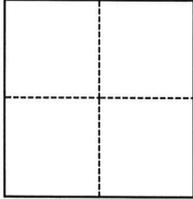


CORNER RECORD

Agency Index

CR-25-448

Document Number

City of Manteca County of San Joaquin, CaliforniaBrief Legal Description Three monuments on Tinnin Road as shown on 14-PM-178 & 44-MP-139.**CORNER TYPE****COORDINATES (Optional)**

- Government Corner Control
 Meander Property
 Rancho Other

N. _____ E. _____

Elevation _____

Units Metric U.S. Survey FootHorizontal Datum NAD 83Zone 3 Epoch Date 1991.35

Vertical Datum _____

 Complies with Public Resources Code §§8801-8819 Complies with Public Resources Code §§8890-8902Date of Survey November 6, 2025PLS Act Ref.: 8765(d) 8771 8773 Other:

Corner/
Monument: Left as found Established Rebuilt Pre-Construction
 Found and tagged Reestablished Referenced Post-Construction

Narrative of corner identified and monument as found, set, reset, replaced, or removed:

 See sheet #2 for description(s):

This Corner Record is the pre-drilling exploration location of found monuments within a 50 ft radius of the proposed boring location. After drilling activities are complete a follow up survey will be performed to confirm that no monuments have been disturbed. If monuments have been disturbed a durable replacement monument will be installed and a Post-Construction Corner Record will be completed and submitted.


SURVEYOR'S STATEMENT

This Corner Record was prepared by me or under my direction in conformance with

the Professional Land Surveyors' Act on December 4, 2025Signed *Carina Garcia* P.L.S. or R.C.E. No. 9916**COUNTY SURVEYOR'S STATEMENT**This Corner Record was received December 5, 2025and examined and filed December 18, 2025Signed *James E. Hart* P.L.S. or R.C.E. No. 8657Title County Surveyor

County Surveyor's Comment



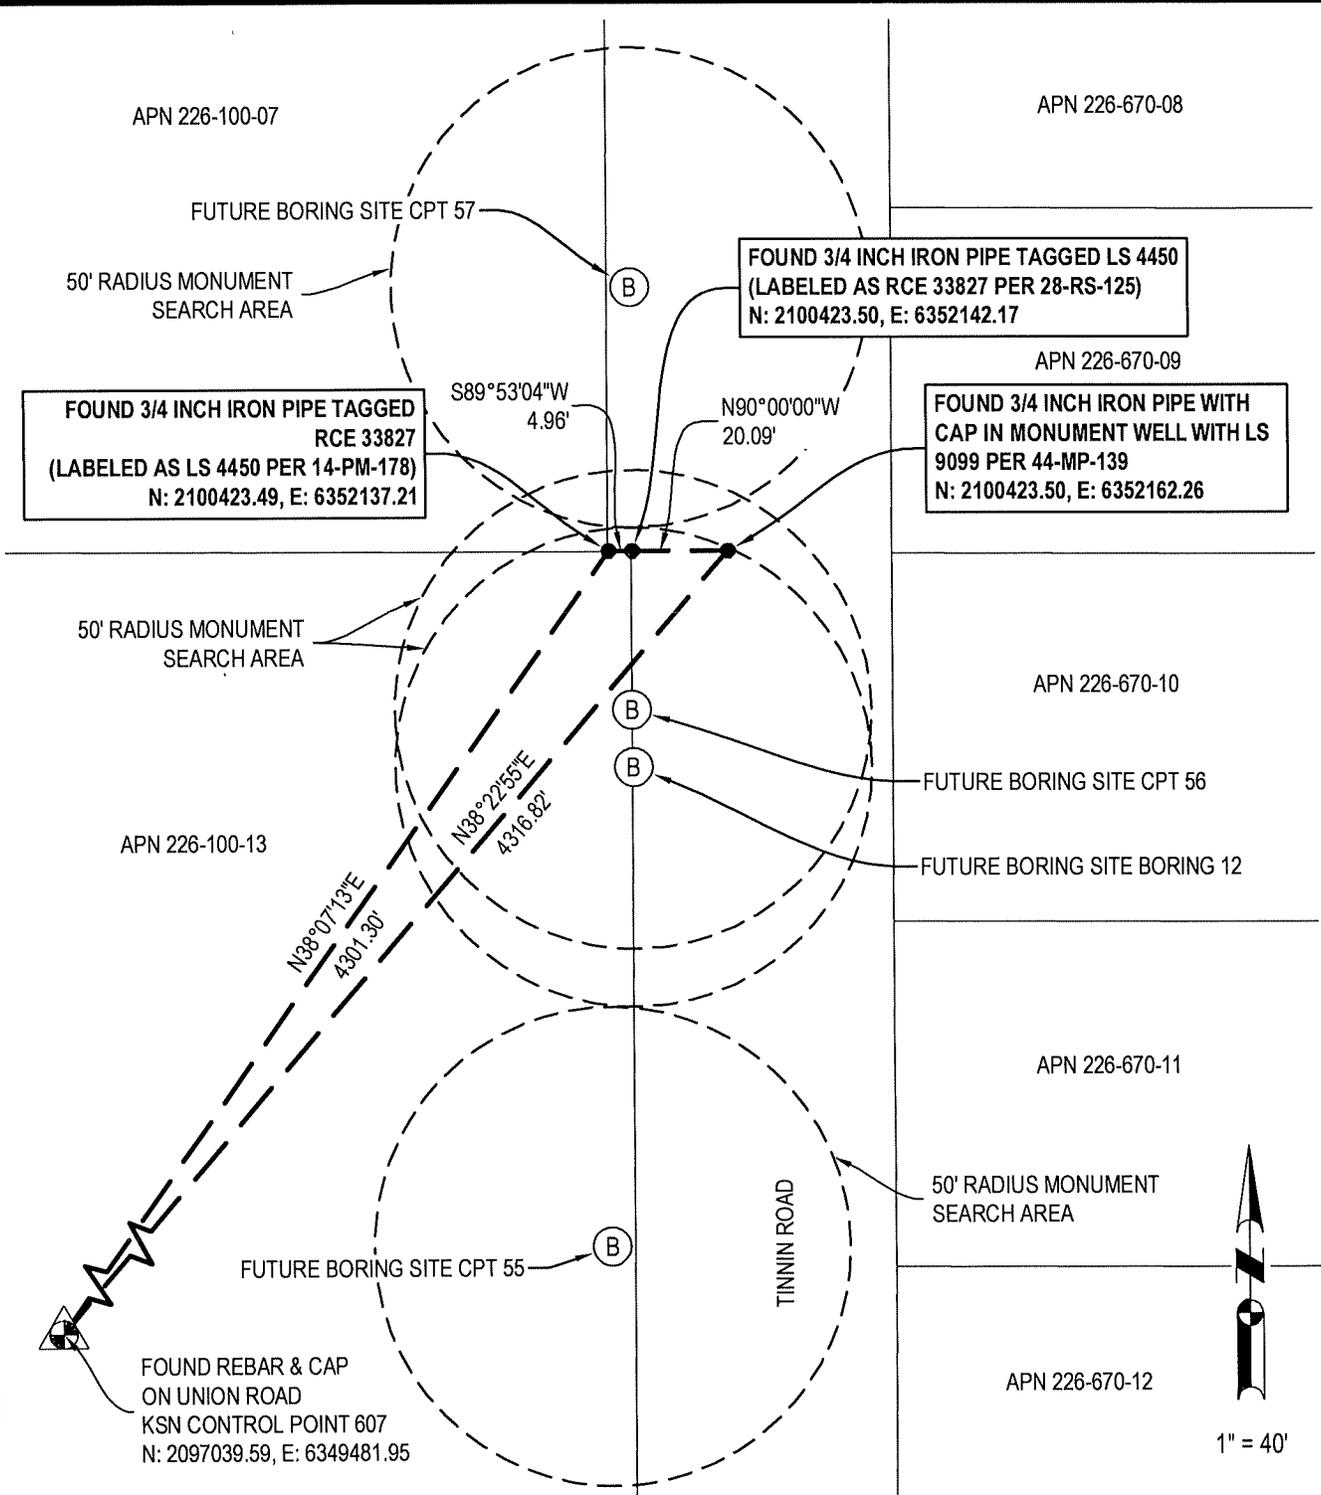

BASIS OF SURVEY CONTROL

ALL BEARINGS, COORDINATES, AND DISTANCES ARE GRID AND BASED ON THE NORTH AMERICAN DATUM OF 1983 (NAD83) CONVERTED TO THE CALIFORNIA COORDINATE SYSTEM OF 1983, ZONE 3 (CCS83, ZONE 3) AS REFERENCED BY AVAILABLE NGS CONTROL MONUMENTS. UNITS SHOWN ARE BASED ON THE U.S. SURVEY FOOT, 1991.35 EPOCH DATE ADJUSTMENT. THIS PROJECT SURVEY CONTROL IS BASED ON THE PRIMARY SURVEY CONTROL NETWORK ESTABLISHED FOR RECLAMATION DISTRICT NO. 17, WHICH IS RECORDED WITH SAN JOAQUIN COUNTY IN BOOK 38 OF SURVEYS AT PAGE 119, DOCUMENT NUMBER 2015-007318.

NOTES:

THIS SURVEY DOES NOT DEFINE BOUNDARY OR RIGHT OF WAY LINES. PARCEL LINES AND ROAD CENTERLINES SHOWN HEREON ARE FOR GENERAL LOCATION AND INFORMATION PURPOSES ONLY TO LOCATE THE PROJECT SITE. SAID LINWORK IS BASED UPON 1/10/2024 SAN JOAQUIN COUNTY GIS PARCEL DATA.



APN: ASSESSOR PARCEL NUMBER
 LS: LAND SURVEYOR
 MP: MAPS AND PLATS, SAN JOAQUIN COUNTY RECORDS

PM: PARCEL MAP, SAN JOAQUIN COUNTY RECORDS
 RCE: REGISTERED CIVIL ENGINEER
 RS: RECORD OF SURVEY, SAN JOAQUIN COUNTY RECORDS