

CORNER RECORD

Agency Index CR-25-449


Document Number _____

City of Lodi County of San Joaquin, California

Brief Legal Description LOT 24, M.&P. 14-54, S.J.C.R.

CORNER TYPE

COORDINATES (Optional)

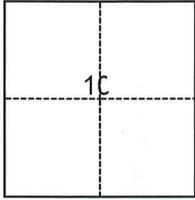

- Government Corner
- Meander
- Rancho
- Control
- Property
- Other

Date of Survey NOVEMBER 11, 2025

N. _____ E. _____

Elevation _____

Units Metric U.S. Survey Foot

Horizontal Datum _____

Zone _____ Epoch Date _____

Vertical Datum _____

Complies with Public Resources Code §§8801-8819

Complies with Public Resources Code §§8890-8902

SECTION 10, T.3N., R.6E., M.D.B.&M.

PLS Act Ref.: 8765(d) 8771 8773 Other:

Corner/Monument: Left as found Established Rebuilt Pre-Construction

Found and tagged Reestablished Referenced Post-Construction

Narrative of corner identified and monument as found, set, reset, replaced, or removed:

See sheet #2 for description(s):

SURVEYOR'S STATEMENT

This Corner Record was prepared by me or under my direction in conformance with the Professional Land Surveyors' Act on December 4, 2025
Signed [Signature] P.L.S. or R.C.E. No. 25835





COUNTY SURVEYOR'S STATEMENT

This Corner Record was received December 5, 2025
and examined and filed December 18, 2025
Signed James E. Hart P.L.S. or R.C.E. No. 8657
Title County Surveyor



County Surveyor's Comment

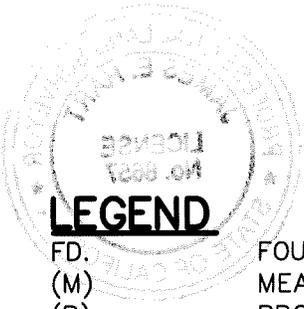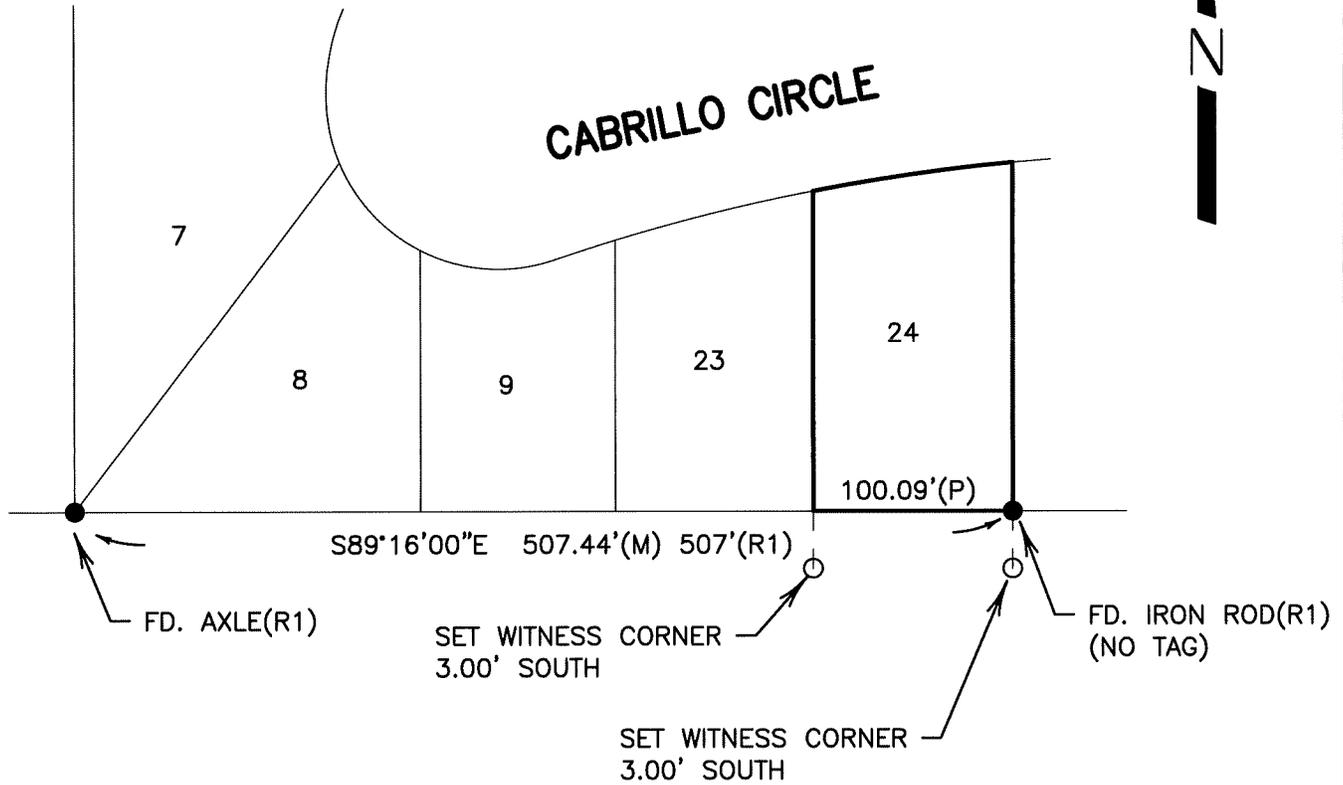

LEGEND

FD. FOUND
 (M) MEASURED
 (P) PRORATED
 S.J.C.R. SAN JOAQUIN COUNTY RECORDS

● FD. MONUMENT AS NOTED
 ○ SET 3/4" X 30" IRON ROD, CAPPED R.C.E. 25835

REFERENCE:

(R1) M.&P. 14-54, S.J.C.R.

25137