

CORNER RECORD

Agency Index CR-25-453
Document Number _____

City of STOCKTON County of SAN JOAQUIN, California

Brief Legal Description FOUND MONUMENTS SHOWN ON CORNER RECORD 24-498, SAN JOAQUIN COUNTY SURVEYORS RECORDS.



C.M. WEBER GRANT

CORNER TYPE

- Government Corner
- Meander
- Rancho
- Control
- Property
- Other

Date of Survey JUNE 9, 2025

COORDINATES (Optional)

N. _____ E. _____

Elevation _____

Units Metric U.S. Survey Foot

Horizontal Datum _____

Zone _____ Epoch Date _____

Vertical Datum _____

Complies with Public Resources Code §§8801-8819

Complies with Public Resources Code §§8890-8902

PLS Act Ref.: 8765(d) 8771 8773 Other:

Corner/Monument: Left as found Established Rebuilt Pre-Construction
 Found and tagged Reestablished Referenced Post-Construction

Narrative of corner identified and monument as found, set, reset, replaced, or removed:

See sheet #2 for description(s):

THE FOUND MONUMENT(S) SHOWN ON THIS CORNER RECORD WERE FOUND AT THE LOCATION OF THE CORNER(S) ON CORNER RECORD 24-498, SAN JOAQUIN COUNTY SURVEYOR'S RECORDS. I DID NOT VERIFY THE IDENTITY AND VALIDITY OF THE MONUMENT(S) FOUND AS ACTUALLY MARKING THE PROPERTY CORNER.

SURVEYOR'S STATEMENT

This Corner Record was prepared by me or under my direction in conformance with
 the Professional Land Surveyors' Act on AUGUST 20, 2025
 Signed [Signature] P.L.S. or R.C.E. No. 8489



COUNTY SURVEYOR'S STATEMENT


This Corner Record was received December 12, 2025
 and examined and filed December 19, 2025
 Signed James E. Hart P.L.S. or R.C.E. No. 8657
 Title County Surveyor



County Surveyor's Comment

Document Number

Agency Index

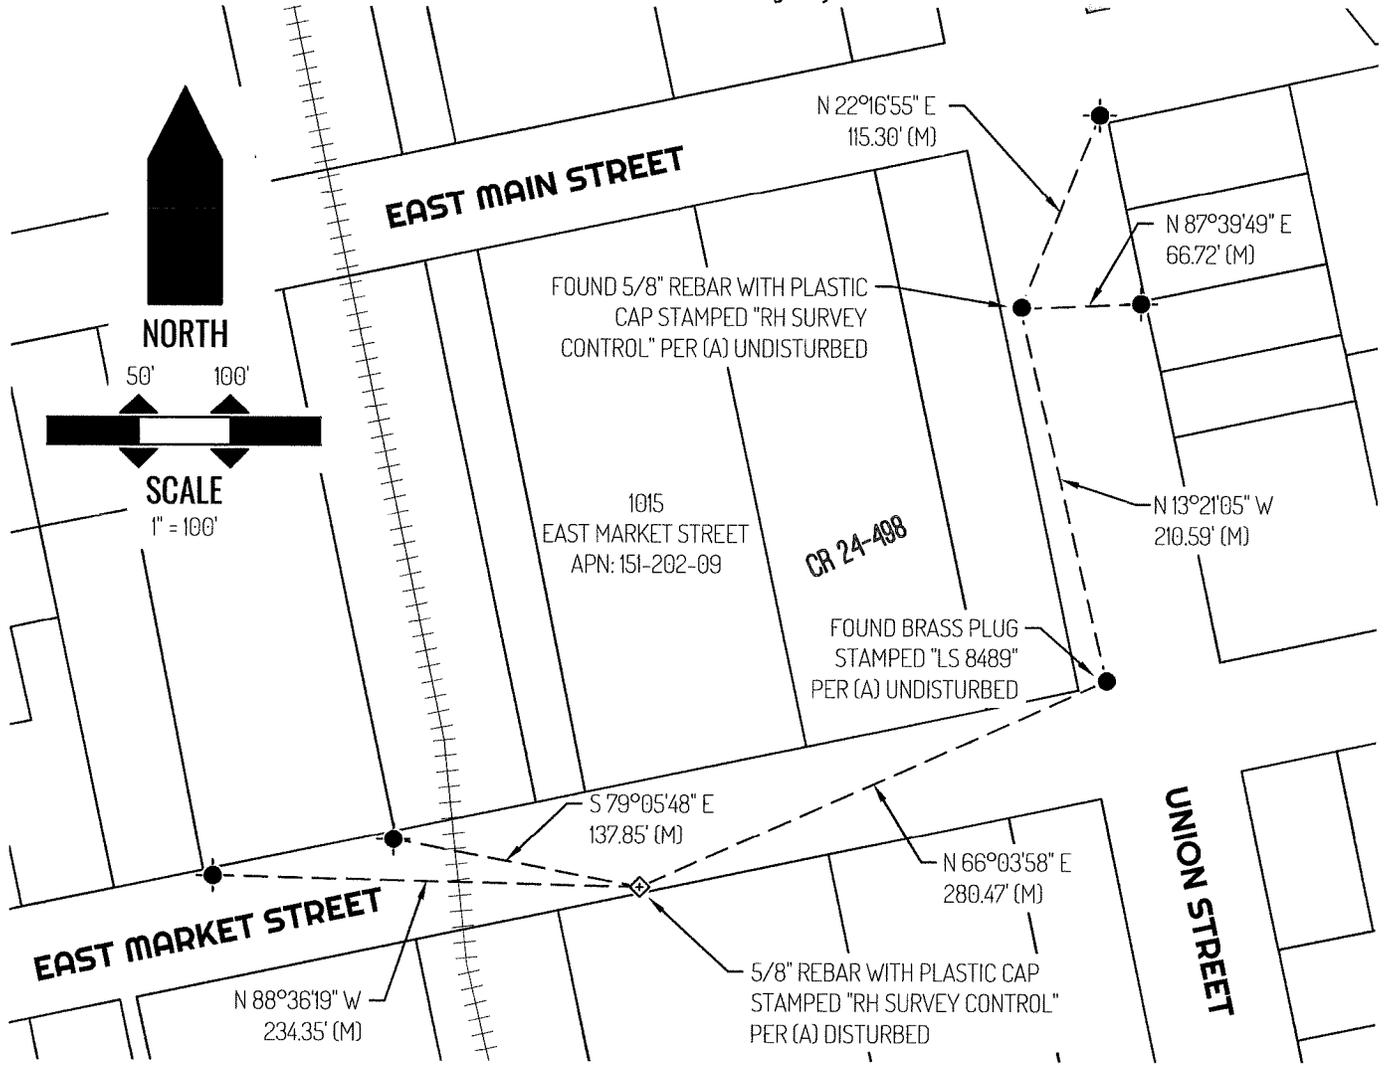

NORTH

50' 100'

SCALE

1" = 100'

LEGEND



FOUND CHISELED CROSS PER (A) UNDISTURBED



FOUND MONUMENT AS NOTED



SEARCH FOUND NOTHING

1015

REFERENCE STREET ADDRESS

CR

CORNER RECORD, SAN JOAQUIN COUNTY SURVEYOR'S RECORDS

APN

TAX ASSESSOR PARCEL NUMBER

(M)

MEASURED



TIE LINE



LOT LINE



UNION PACIFIC RAILROAD

REFERENCE

(A) CORNER RECORD 24-498, SAN JOAQUIN COUNTY SURVEYOR'S RECORDS