

CORNER RECORD

Agency Index CR-25-456

Document Number _____

City of _____ County of SAN JOAQUIN, CaliforniaBrief Legal Description FOUND MONUMENTS EAST OF HARLAN ROAD, PER CORNER RECORD 24-404, SAN JOAQUIN COUNTY SURVEYOR'S RECORDS.**CORNER TYPE****COORDINATES (Optional)**

C.M. WEBER GRANT

- Government Corner Control
 Meander Property
 Rancho Other

Date of Survey March 28, 2025

N. _____ E. _____

Elevation _____

Units Metric U.S. Survey Foot

Horizontal Datum _____

Zone _____ Epoch Date _____

Vertical Datum _____

 Complies with Public Resources Code §§8801-8819 Complies with Public Resources Code §§8890-8902PLS Act Ref.: 8765(d) 8771 8773 Other:

Corner/Monument: Left as found Established Rebuilt Pre-Construction
 Found and tagged Reestablished Referenced Post-Construction

Narrative of corner identified and monument as found, set, reset, replaced, or removed:

 See sheet #2 for description(s):

THE FOUND MONUMENT(S) SHOWN ON THIS CORNER RECORD WERE FOUND AT THE LOCATION OF THE CORNER(S) ON CR 24-404, SAN JOAQUIN COUNTY SURVEYOR'S RECORDS. I DID NOT VERIFY THE IDENTITY AND VALIDITY OF THE MONUMENT(S) FOUND AS ACTUALLY MARKING THE PROPERTY CORNER.

SURVEYOR'S STATEMENT

This Corner Record was prepared by me or under my direction in conformance with the Professional Land Surveyors' Act on April 9, 2025.

Signed [Signature] P.L.S. or R.C.E. No. 8489

**COUNTY SURVEYOR'S STATEMENT**

This Corner Record was received December 12, 2025 and examined and filed December 19, 2025.


Signed James E. Hart P.L.S. or R.C.E. No. 8657

Title County Surveyor


**County Surveyor's Comment**

Document Number

Agency Index

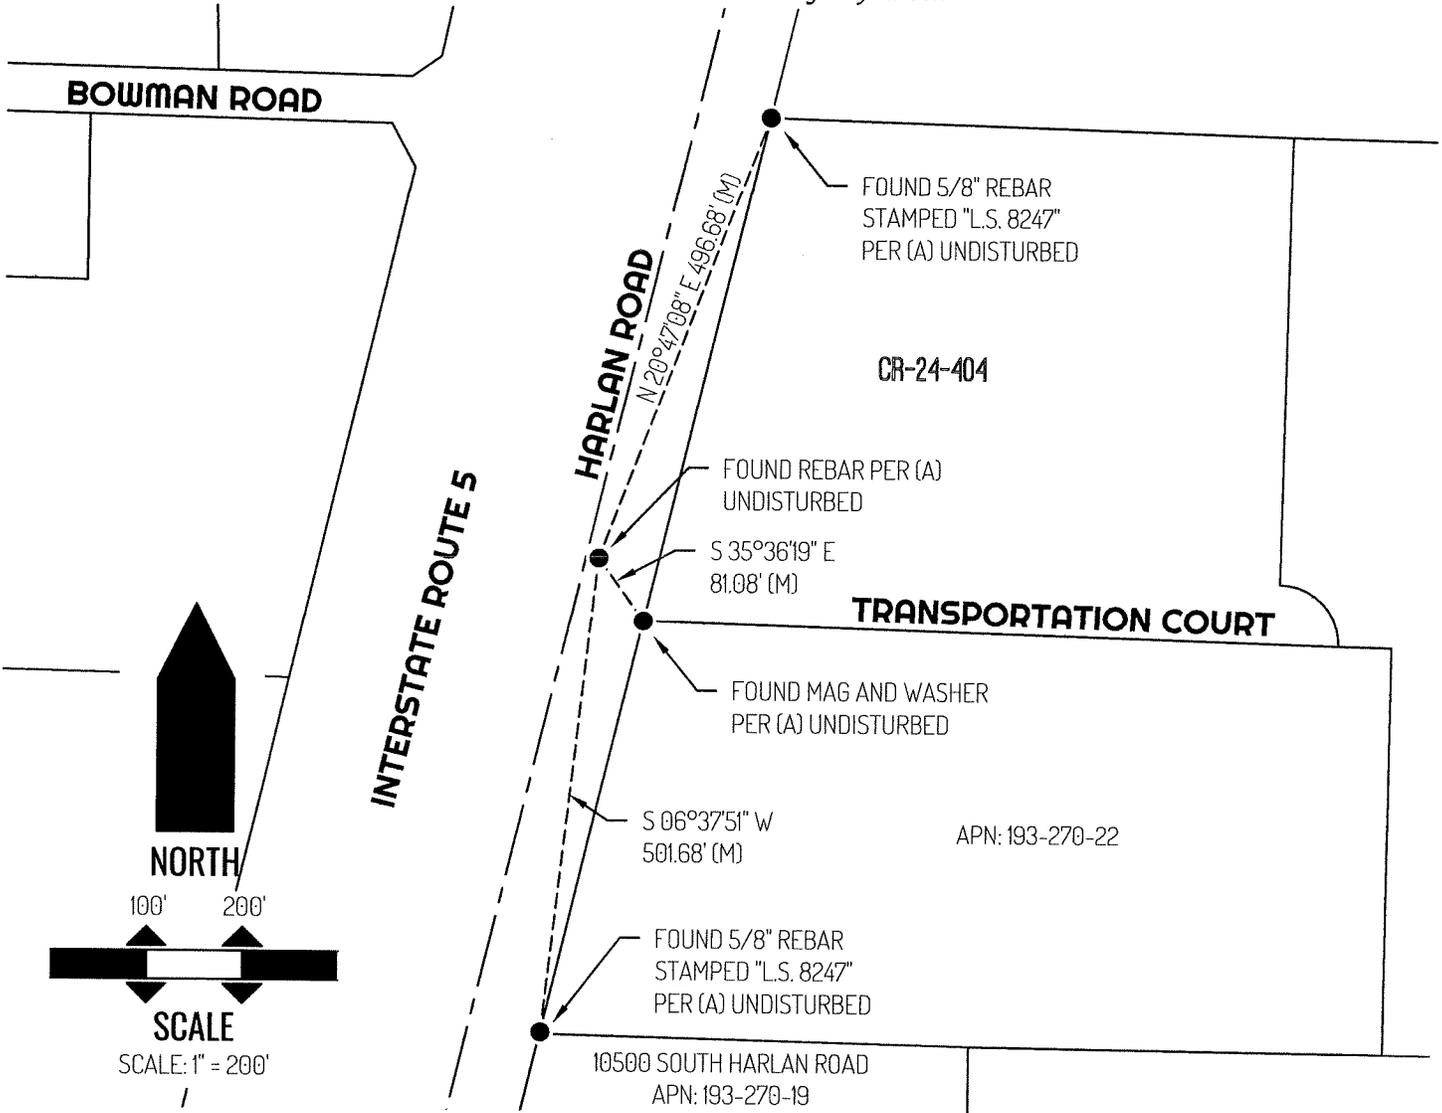

100' 200'

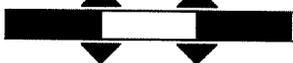

SCALE

SCALE: 1" = 200'

LEGEND

- FOUND MONUMENT AS NOTED
- 10500 REFERENCE STREET ADDRESS
- CR CORNER RECORD, SAN JOAQUIN COUNTY SURVEYOR'S RECORDS
- APN TAX ASSESSOR PARCEL NUMBER
- (M) MEASURED
- TIE LINE
- ===== LOT LINE
- RIGHT-OF-WAY CENTERLINE

REFERENCE

(A) CORNER RECORD 24-404, SAN JOAQUIN COUNTY SURVEYOR'S RECORDS