


CORNER RECORD

Agency Index CR-25-476
 Document Number _____

City of _____ County of San Joaquin, California

Brief Legal Description Mariposa Road @ Pock Lane
Within Section 46, C.M. Weber Grant

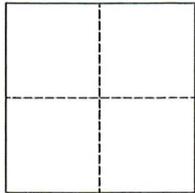

CORNER TYPE

Government Corner Control
 Meander Property
 Rancho Other
 Date of Survey July 14, 2023

COORDINATES (Optional)

N. _____ E. _____
 Elevation. _____
 Units Metric U.S. Survey Foot
 Horizontal Datum _____
 Zone _____ Epoch Date _____
 Vertical Datum _____
 Complies with Public Resources Code §§8801-8819
 Complies with Public Resources Code §§8890-8902


PLS Act Ref.: 8765(d) 8771 8773 Other:

Corner/Monument: Left as found Established Rebuilt Pre-Construction
 Found and tagged Reestablished Referenced Post-Construction

Narrative of corner identified and monument as found, set, reset, replaced, or removed:
 See sheet #2 for description(s):

SURVEYOR'S STATEMENT

This Corner Record was prepared by me or under my direction in conformance with
 the Professional Land Surveyor's Act on November 10, 2025
 Signed Robert L. Borsdorf III P.L.S. or R.C.E. No. 9728

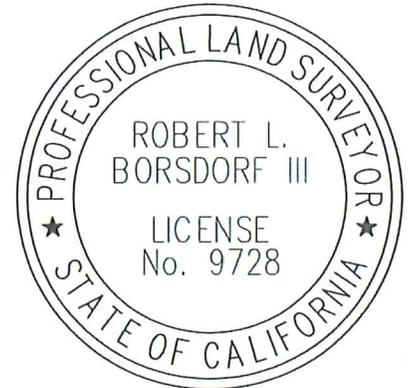


COUNTY SURVEYOR'S STATEMENT

This Corner Record was received December 9, 2025
 and examined and filed December 31, 2025
 Signed James E. Hart P.L.S. or R.C.E. No. 8657
 Title _____ County Surveyor



County Surveyor's Comment

N.T.S.

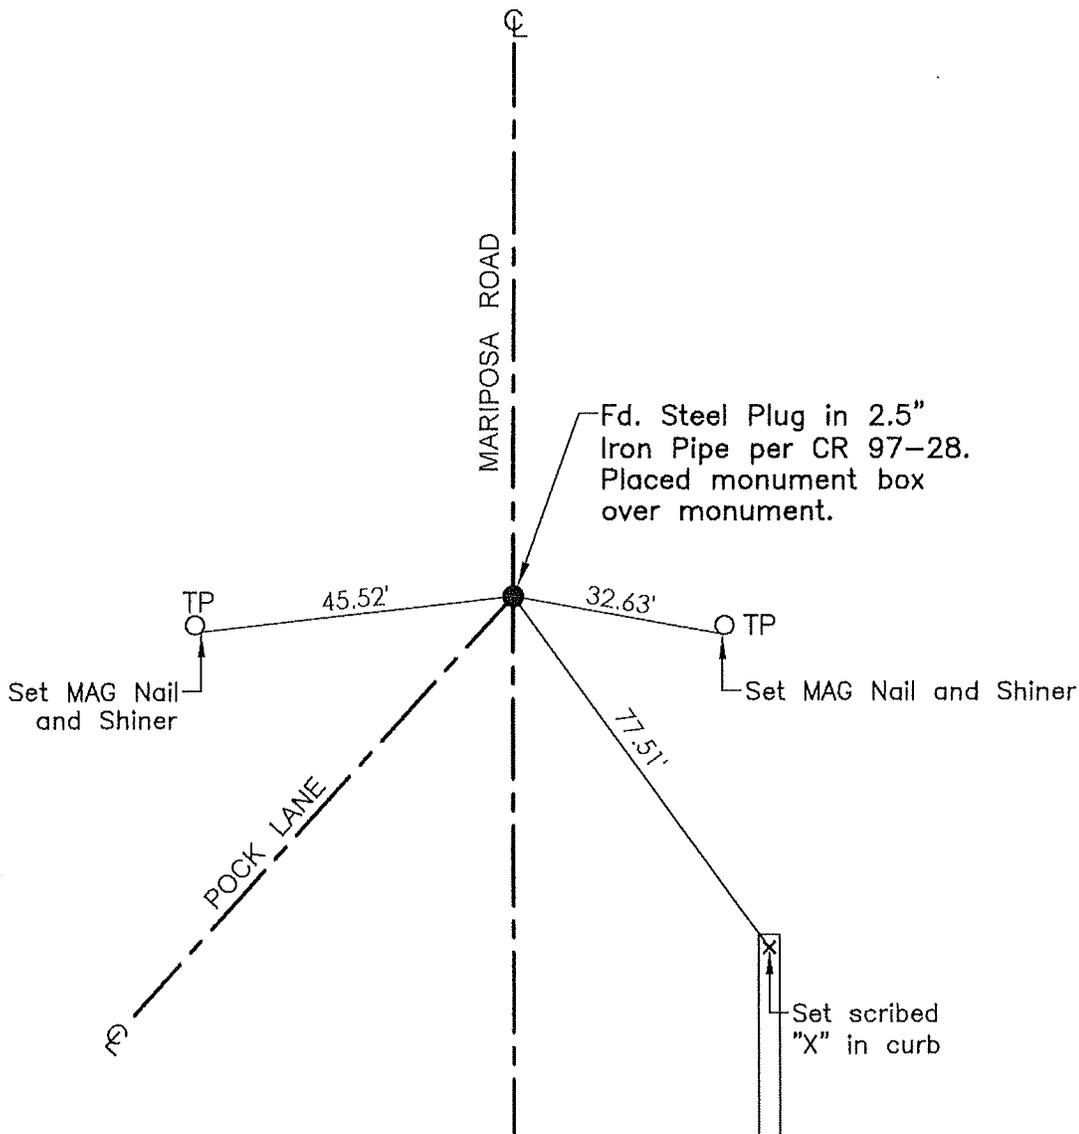

Fd. Steel Plug in 2.5" Iron Pipe per CR 97-28. Placed monument box over monument.

TP
45.52'
Set MAG Nail and Shiner

32.63'
TP
Set MAG Nail and Shiner

77.51'
Set scribed "X" in curb

- TR=Tree
- MB=Mailbox
- BM=Bench Mark
- EP=Edge of Pavement
- YL=Yellow Line
- FH=Fire Hydrant
- CR=Corner Record
- FP=Fence Post
- JP=Joint Pole
- LP=Light Pole
- PP=Power Pole
- GP=Guy Pole
- SP=Service Pole
- TP=Telephone Pole
- S.F.N.=Searched Found Nothing
- N.T.S.=Not To Scale
- M&P=Maps & Plats
- PM=Parcel Map
- RS=Record of Survey
- FB=Field Book
- N=North
- SDI=Storm Drain Inlet
- TOC=Top of Curb
- PCC=Portland Cement Concrete

Set=Conc. Nail with Brass Washer stamped "S.J. Co.", unless otherwise noted
 Fd.=Found Conc. Nail with Brass Washer stamped "S.J. Co.", unless otherwise noted
 Note: Found Monuments are not tagged unless otherwise noted.

"No attempt was made to verify the Monument(s)"