


# CORNER RECORD

Agency Index: CR-26-001

Document Number: \_\_\_\_\_

City of \_\_\_\_\_ County of SAN JOAQUIN, California

Brief Legal Description ONE MONUMENT FOUND ON THE CENTERLINE OF BRENNAN ROAD IN THE PROXIMITY OF THE INTERSECTION WITH THE B.N.S.F. RAILROAD RIGHT-OF-WAY

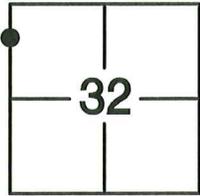

T.1S, R.9E

### CORNER TYPE

- Government Corner
- Meander
- Rancho
- Control
- Property
- Other

Date of Survey 7-17-25

### COORDINATES (Optional)

N. \_\_\_\_\_ E. \_\_\_\_\_

Elevation \_\_\_\_\_

Units  Metric  U.S. Survey Foot

Horizontal Datum \_\_\_\_\_

Zone \_\_\_\_\_ Epoch Date \_\_\_\_\_

Vertical Datum \_\_\_\_\_

Complies with Public Resources Code §§8801-8819

Complies with Public Resources Code §§8890-8902

PLS Act Ref:  8765(d)  8771  8773  Other:

Corner/Monument:  Left as found  Established  Rebuilt  Pre-Construction  
 Found and Tagged  Reestablished  Referenced  Post-Construction

Narrative of corner identified and monument as found, set, reset, replaced, or removed:

See sheet #2 for description(s):

FOUND MONUMENT AS SHOWN ON SHEET 2.

### SURVEYOR'S STATEMENT

This Corner Record was prepared by me or under my direction in conformance with the Land Surveyors' Act on DECEMBER 9, 2025,

Signed Tanya Cissell P.L.S. 9857 Number 9857



### COUNTY SURVEYOR'S STATEMENT

This Corner Record was received December 9, 2025


and examined and filed January 2, 2026

Signed James E. Hart P.L.S. or R.C.E. No: 8657

Title County Surveyor



County Surveyor's Comment \_\_\_\_\_

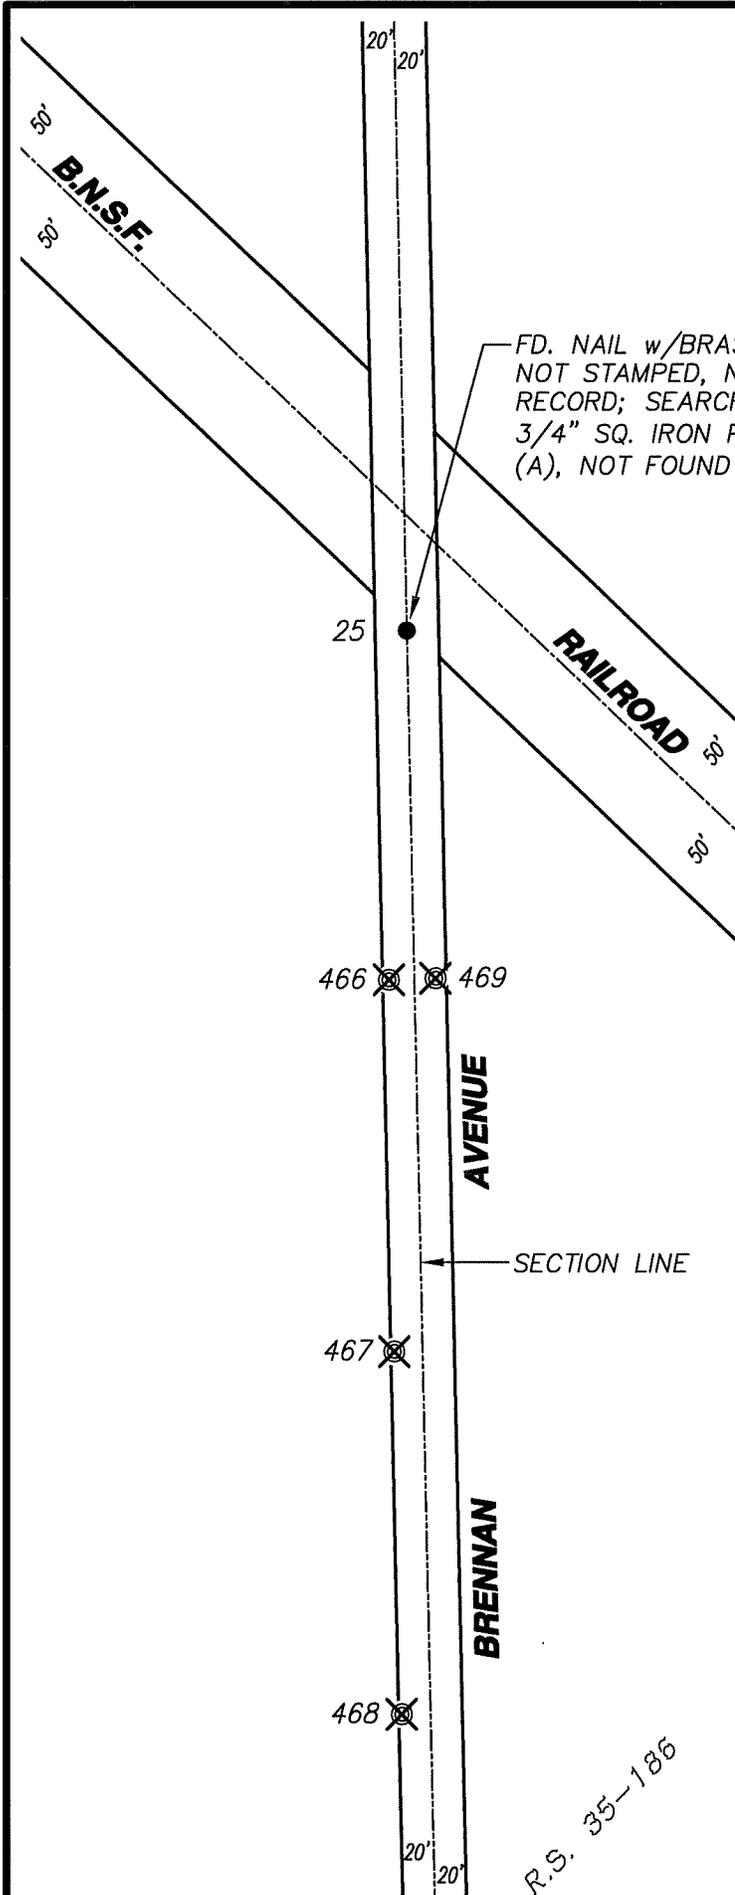

SCALE: 1" = 120'

MON #	NORTHING (FEET)	EASTING (FEET)
25	2118051.27'	6412800.62'
466	2117831.95'	6412789.48'
467	2117598.38'	6412792.87'
468	2117370.59'	6412797.56'
469	2117832.84'	6412818.78'

**NOTE:**

THIS CORNER RECORD DOES NOT VERIFY THIS MONUMENT TO BE IN THE CORRECT POSITION.

**REFERENCE:**

(A) R.S. 35-186, S.J.C.R.

**LEGEND:**

- ⊗ SET 3/4" IRON PIPE, TAGGED LS 9857
- FOUND MONUMENT AS NOTED.
- FD. FOUND.
- R.S. RECORD OF SURVEY, S.J.C.R.
- S.J.C.R. SAN JOAQUIN COUNTY RECORDS.
- (M) MEASURED DISTANCE.