


CORNER RECORD

Agency Index: CR-26-003

Document Number: _____

City of _____ County of SAN JOAQUIN, California

Brief Legal Description ONE MONUMENT FOUND ON THE EAST RIGHT-OF-WAY LINE OF SEXTON ROAD.

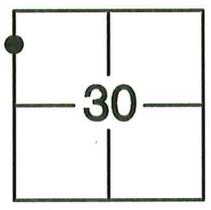

T.1S, R.9E

CORNER TYPE

- Government Corner
- Meander
- Rancho
- Control
- Property
- Other

Date of Survey 7-16-25

COORDINATES (Optional)

N. _____ E. _____
 Elevation _____
 Units Metric U.S. Survey Foot
 Horizontal Datum _____
 Zone _____ Epoch Date _____
 Vertical Datum _____
 Complies with Public Resources Code §§8801-8819
 Complies with Public Resources Code §§8890-8902

PLS Act Ref: 8765(d) 8771 8773 Other:

Corner/Monument: Left as found Established Rebuilt Pre-Construction
 Found and Tagged Reestablished Referenced Post-Construction

Narrative of corner identified and monument as found, set, reset, replaced, or removed:
 See sheet #2 for description(s):
FOUND MONUMENT AS SHOWN ON SHEET 2.

SURVEYOR'S STATEMENT

This Corner Record was prepared by me or under my direction in conformance with the Land Surveyors' Act on DECEMBER 9, 2025,

Signed Tanya Cissell P.L.S. ██████████ Number 9857




COUNTY SURVEYOR'S STATEMENT

This Corner Record was received December 9, 2025
 and examined and filed January 2, 2026

Signed James E. Hart P.L.S. or R.C.E. No: 8657
 Title County Surveyor



County Surveyor's Comment _____

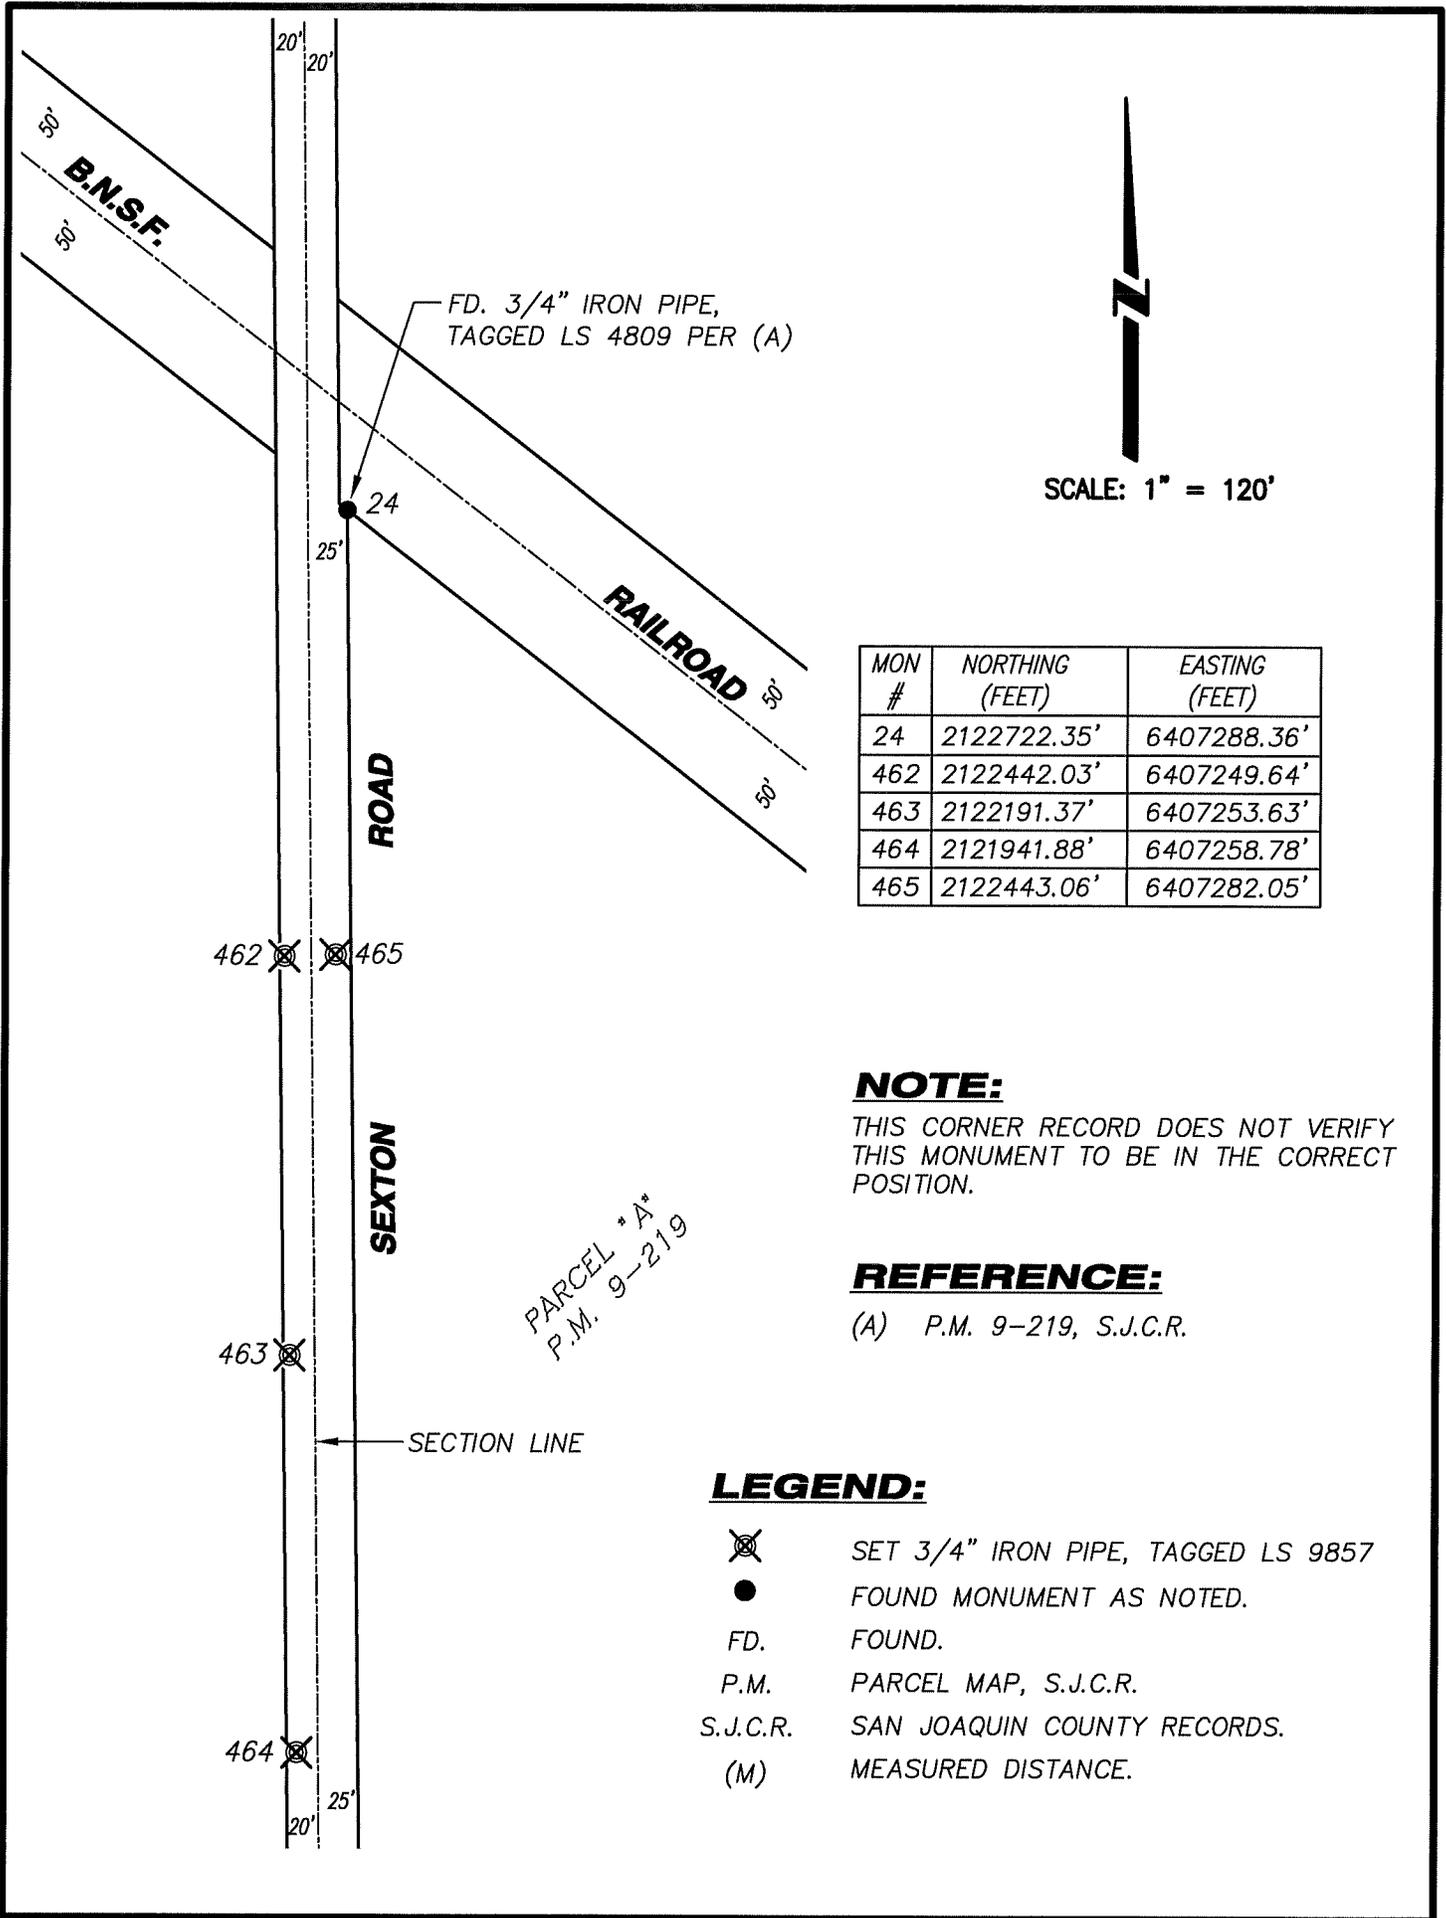

MON #	NORTHING (FEET)	EASTING (FEET)
24	2122722.35'	6407288.36'
462	2122442.03'	6407249.64'
463	2122191.37'	6407253.63'
464	2121941.88'	6407258.78'
465	2122443.06'	6407282.05'

NOTE:

THIS CORNER RECORD DOES NOT VERIFY THIS MONUMENT TO BE IN THE CORRECT POSITION.

REFERENCE:

(A) P.M. 9-219, S.J.C.R.

LEGEND:

- ⊗ SET 3/4" IRON PIPE, TAGGED LS 9857
- FOUND MONUMENT AS NOTED.
- FD. FOUND.
- P.M. PARCEL MAP, S.J.C.R.
- S.J.C.R. SAN JOAQUIN COUNTY RECORDS.
- (M) MEASURED DISTANCE.