


CORNER RECORD

Agency Index CR-26-012

Document Number _____

City of _____ County of San Joaquin, California

Brief Legal Description Intersection of Liberty Road and Sowles Road.

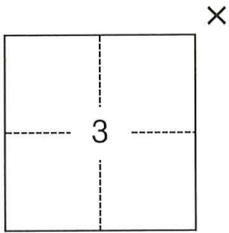

CORNER TYPE

- Government Corner
- Meander
- Rancho
- Control
- Property
- Other

Date of Survey October 29, 2025

COORDINATES (Optional)

N. _____ E. _____

Elevation _____

Units Metric U.S. Survey Foot

Horizontal Datum _____

Zone _____ Epoch Date _____

Vertical Datum _____

Complies with Public Resources Code §§8801-8819

Complies with Public Resources Code §§8890-8902

T.4N. R.7E.

PLS Act Ref.: 8765(d) 8771 8773 Other:

Corner/Monument: Left as found Established Rebuilt Pre-Construction

Found and tagged Reestablished Referenced Post-Construction

Narrative of corner identified and monument as found, set, reset, replaced, or removed:

See sheet #2 for description(s):

-All references are to San Joaquin County Surveyor's Records (S.J.C.S.R.)

-All distances shown on sheet 2 are in feet and decimals thereof.

SURVEYOR'S STATEMENT

This Corner Record was prepared by me or under my direction in conformance with

the Professional Land Surveyors' Act on December 2, 2025

Signed *Dani Cano* P.L.S. or R.C.E. No. 9892



COUNTY SURVEYOR'S STATEMENT

This Corner Record was received December 17, 2025


and examined and filed January 2, 2026

Signed *James E. Hart* P.L.S. or R.C.E. No. 8657

Title County Surveyor

County Surveyor's Comment _____



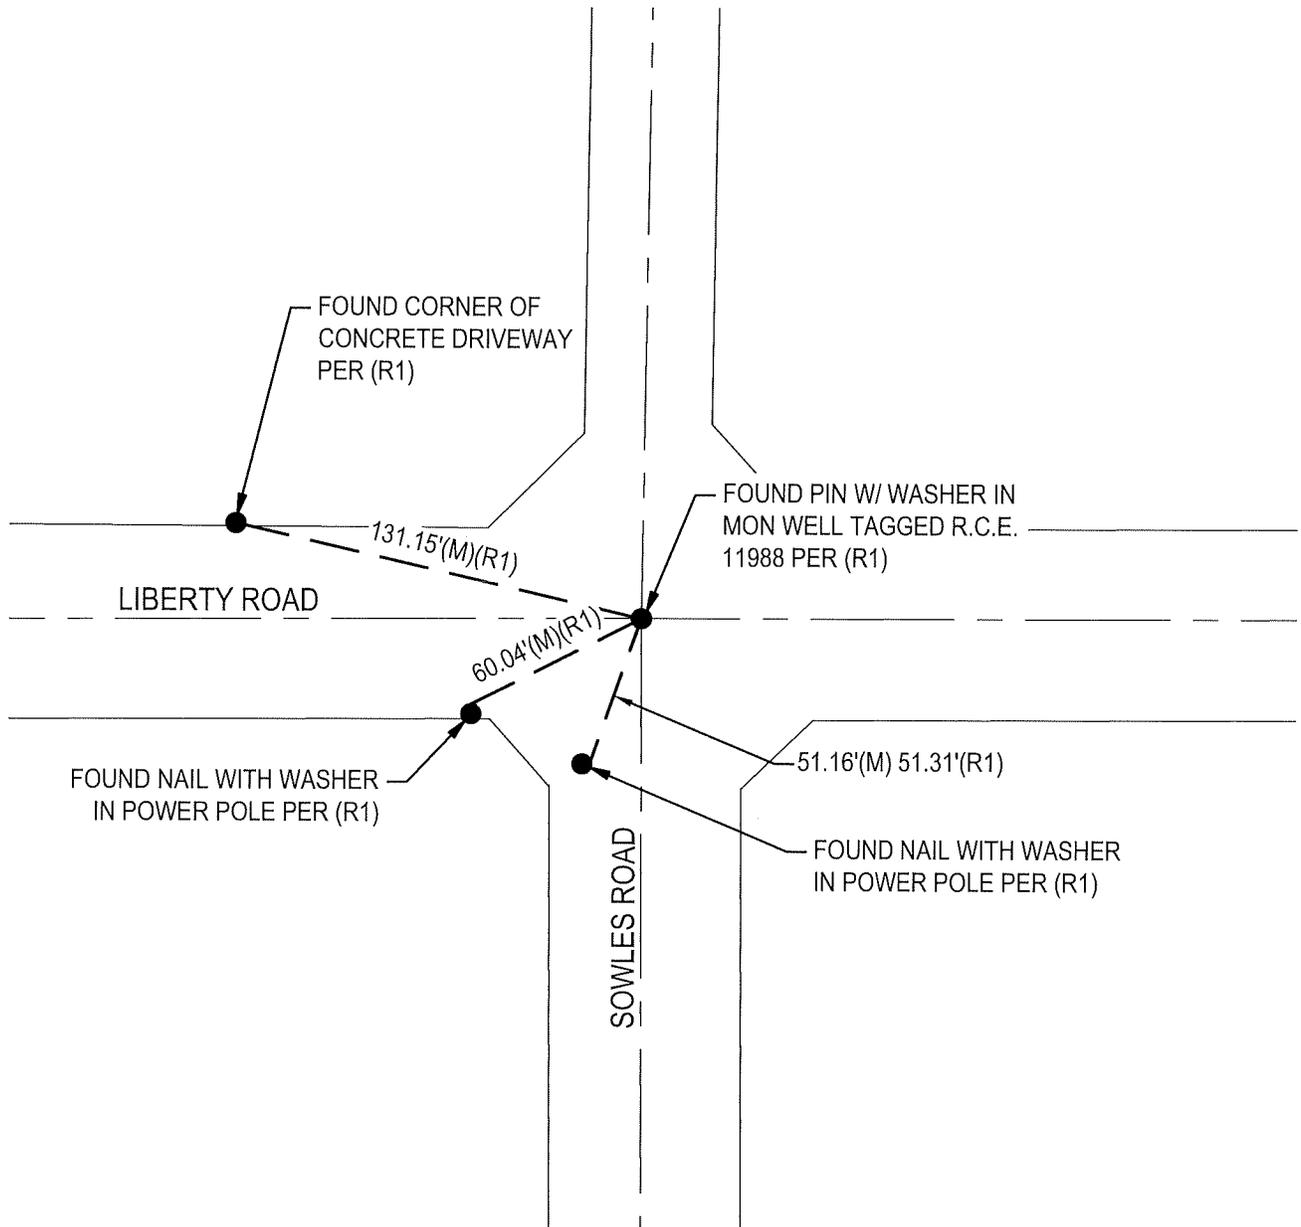

LEGEND

- CR CORNER RECORD
- (M) MEASURED THIS SURVEY
- S.J.C.S.R. SAN JOAQUIN COUNTY SURVEYOR'S RECORDS
- S.F.N. SEARCHED, FOUND NOTHING
- TIE LINE
- PROPERTY LINE
- FOUND MONUMENT AS NOTED
- SET MONUMENT AS NOTED

REFERENCES

(R1) CR-22-010, S.J.C.S.R.

SURVEYOR'S NOTE

THIS DOCUMENT IS BEING FILED TO COMPLY WITH THE PRE-CONSTRUCTION MONUMENT PRESERVATION REQUIREMENTS OUTLINED IN SECTION 8771 OF THE CALIFORNIA BUSINESS AND PROFESSIONS CODE. IT IS NOT THE OUTCOME OF A FINALIZED BOUNDARY SURVEY FOR ANY SPECIFIC PARCEL OF REAL PROPERTY.

