


# CORNER RECORD

Agency Index CR-26-013

Document Number \_\_\_\_\_

City of \_\_\_\_\_ County of San Joaquin, California

Brief Legal Description Liberty Road 2647+/- east of Bruella Road.

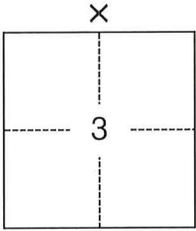

### CORNER TYPE

- Government Corner
- Meander
- Rancho
- Control
- Property
- Other

Date of Survey October 29, 2025

### COORDINATES (Optional)

N. \_\_\_\_\_ E. \_\_\_\_\_

Elevation \_\_\_\_\_

Units  Metric  U.S. Survey Foot

Horizontal Datum \_\_\_\_\_

Zone \_\_\_\_\_ Epoch Date \_\_\_\_\_

Vertical Datum \_\_\_\_\_

Complies with Public Resources Code §§8801-8819

Complies with Public Resources Code §§8890-8902

T.4N. R.7E.

PLS Act Ref.:  8765(d)  8771  8773  Other:

Corner/Monument:  Left as found  Established  Rebuilt  Pre-Construction

Found and tagged  Reestablished  Referenced  Post-Construction

Narrative of corner identified and monument as found, set, reset, replaced, or removed:

See sheet #2 for description(s):

-All references are to San Joaquin County Surveyor's Records (S.J.C.S.R.)

-All distances shown on sheet 2 are in feet and decimals thereof.

### SURVEYOR'S STATEMENT

This Corner Record was prepared by me or under my direction in conformance with

the Professional Land Surveyors' Act on December 2, 2025

Signed *Dani Cano* P.L.S. or R.C.E. No. 9892



### COUNTY SURVEYOR'S STATEMENT

This Corner Record was received December 17, 2025


and examined and filed January 2, 2026

Signed *James E. Hart* P.L.S. or R.C.E. No. 8657

Title County Surveyor

County Surveyor's Comment \_\_\_\_\_



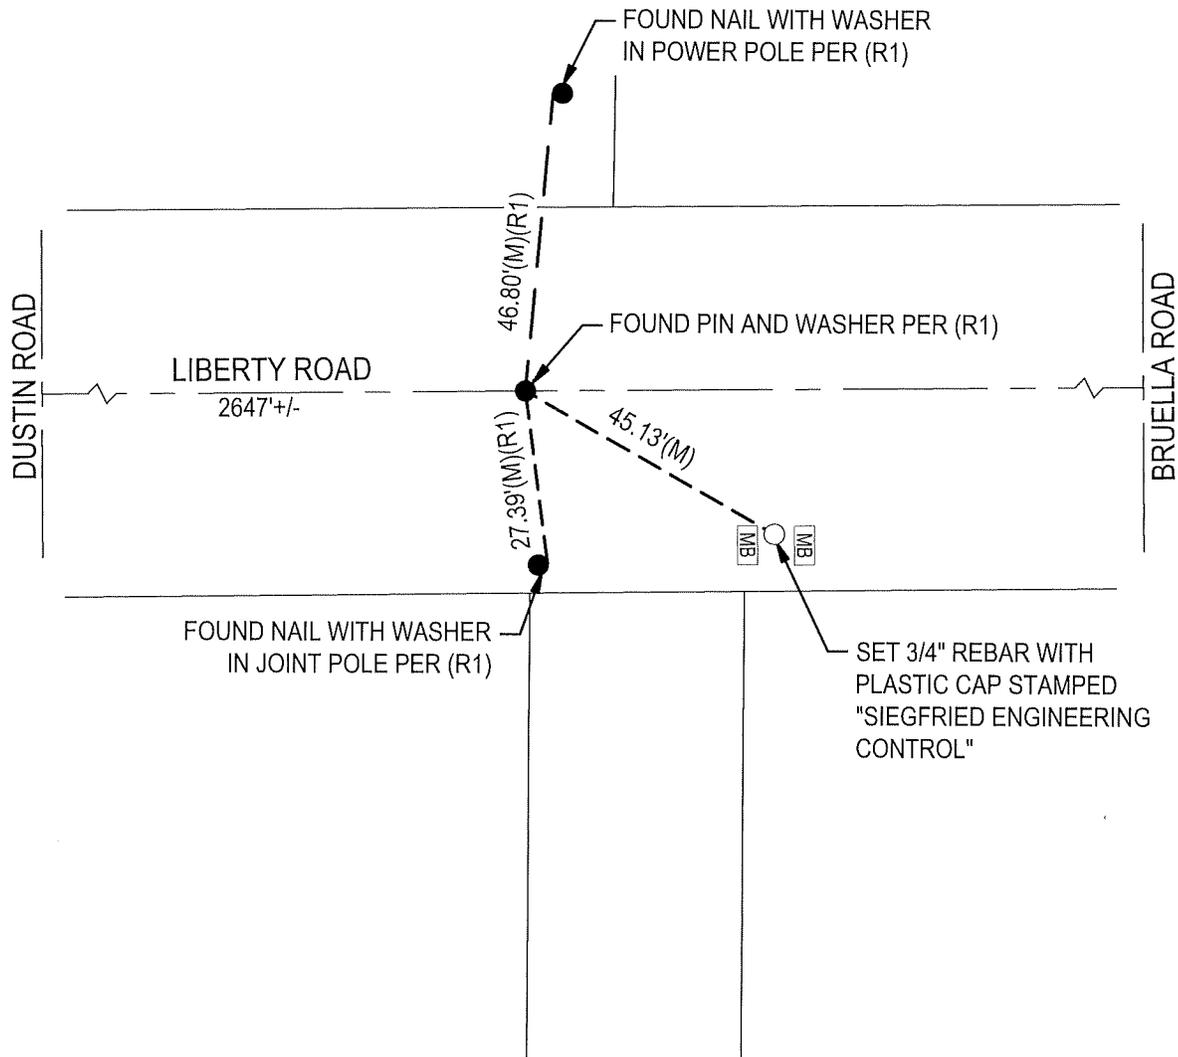

**LEGEND**

- MB MAILBOX
- CR CORNER RECORD
- (M) MEASURED THIS SURVEY
- S.J.C.S.R. SAN JOAQUIN COUNTY SURVEYOR'S RECORDS
- S.F.N. SEARCHED, FOUND NOTHING
- TIE LINE
- PROPERTY LINE
- FOUND MONUMENT AS NOTED
- SET MONUMENT AS NOTED

**REFERENCES**

(R1) CR-22-008, S.J.C.S.R.

**SURVEYOR'S NOTE**

THIS DOCUMENT IS BEING FILED TO COMPLY WITH THE PRE-CONSTRUCTION MONUMENT PRESERVATION REQUIREMENTS OUTLINED IN SECTION 8771 OF THE CALIFORNIA BUSINESS AND PROFESSIONS CODE. IT IS NOT THE OUTCOME OF A FINALIZED BOUNDARY SURVEY FOR ANY SPECIFIC PARCEL OF REAL PROPERTY.

