


CORNER RECORD

Agency Index CR-26-014
 Document Number _____

City of _____ County of San Joaquin, California
 Brief Legal Description Intersection of Liberty Road and Bruella Road.

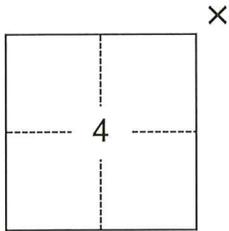

- CORNER TYPE**
- Government Corner Control
 Meander Property
 Rancho Other

Date of Survey October 29, 2025

COORDINATES (Optional)

N. _____ E. _____
 Elevation _____
 Units Metric U.S. Survey Foot
 Horizontal Datum _____
 Zone _____ Epoch Date _____
 Vertical Datum _____
 Complies with Public Resources Code §§8801-8819
 Complies with Public Resources Code §§8890-8902

T.4N. R.7E.

- PLS Act Ref.: 8765(d) 8771 8773 Other:
- Corner/Monument: Left as found Established Rebuilt Pre-Construction
 Found and tagged Reestablished Referenced Post-Construction

Narrative of corner identified and monument as found, set, reset, replaced, or removed:

See sheet #2 for description(s):

- All references are to San Joaquin County Surveyor's Records (S.J.C.S.R.)
- All distances shown on sheet 2 are in feet and decimals thereof.

SURVEYOR'S STATEMENT

This Corner Record was prepared by me or under my direction in conformance with
 the Professional Land Surveyors' Act on December 2, 2025
 Signed [Signature] P.L.S. or R.C.E. No. 9892




COUNTY SURVEYOR'S STATEMENT

This Corner Record was received December 17, 2025
 and examined and filed January 2, 2026
 Signed James E. Hart P.L.S. or R.C.E. No. 8657
 Title County Surveyor



County Surveyor's Comment _____

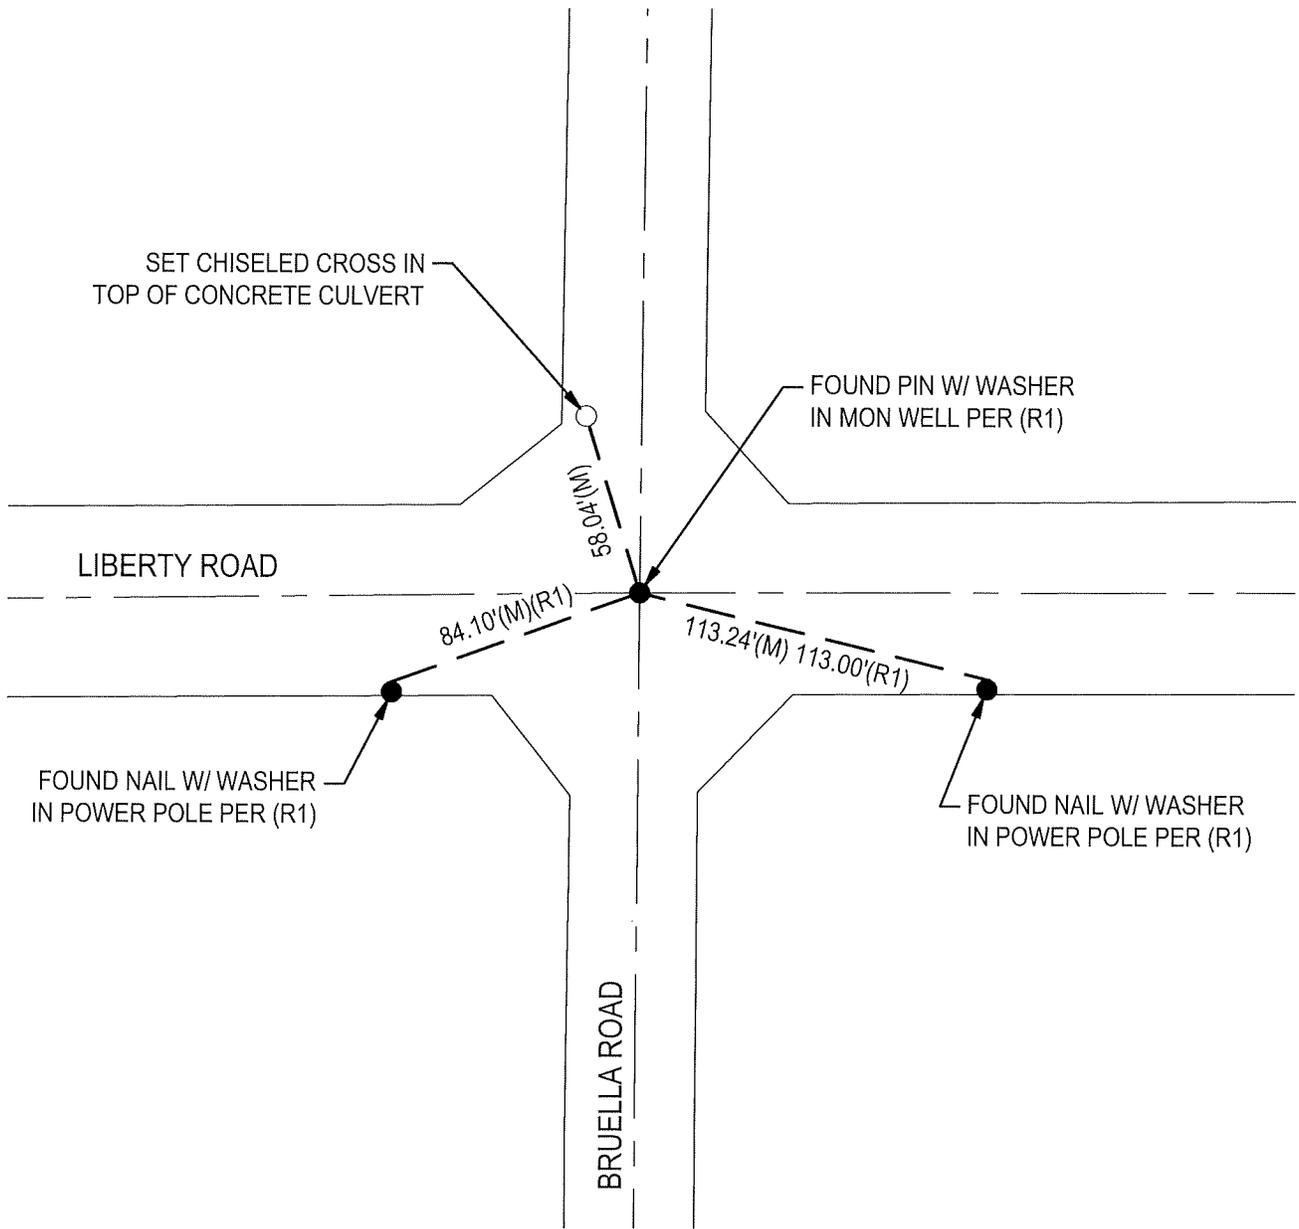

LEGEND

- CR CORNER RECORD
- (M) MEASURED THIS SURVEY
- S.J.C.S.R. SAN JOAQUIN COUNTY SURVEYOR'S RECORDS
- S.F.N. SEARCHED, FOUND NOTHING
- TIE LINE
- PROPERTY LINE
- FOUND MONUMENT AS NOTED
- SET MONUMENT AS NOTED

REFERENCES

(R1) CR-15-112, S.J.C.S.R.

SURVEYOR'S NOTE

THIS DOCUMENT IS BEING FILED TO COMPLY WITH THE PRE-CONSTRUCTION MONUMENT PRESERVATION REQUIREMENTS OUTLINED IN SECTION 8771 OF THE CALIFORNIA BUSINESS AND PROFESSIONS CODE. IT IS NOT THE OUTCOME OF A FINALIZED BOUNDARY SURVEY FOR ANY SPECIFIC PARCEL OF REAL PROPERTY.

