


# CORNER RECORD

Agency Index CR-26-015  
 Document Number \_\_\_\_\_

City of \_\_\_\_\_ County of San Joaquin, California  
 Brief Legal Description Intersection of Liberty Road and Dustin Road.

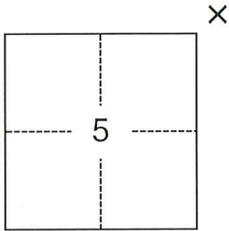

- CORNER TYPE**
- Government Corner
  - Meander
  - Rancho
  - Control
  - Property
  - Other

Date of Survey October 29, 2025

**COORDINATES (Optional)**

N. \_\_\_\_\_ E. \_\_\_\_\_  
 Elevation \_\_\_\_\_  
 Units  Metric  U.S. Survey Foot  
 Horizontal Datum \_\_\_\_\_  
 Zone \_\_\_\_\_ Epoch Date \_\_\_\_\_  
 Vertical Datum \_\_\_\_\_  
 Complies with Public Resources Code §§8801-8819  
 Complies with Public Resources Code §§8890-8902

T.4N. R.7E.

- PLS Act Ref.:  8765(d)  8771  8773  Other: \_\_\_\_\_
- Corner/Monument:  Left as found  Established  Rebuilt  Pre-Construction  
 Found and tagged  Reestablished  Referenced  Post-Construction

Narrative of corner identified and monument as found, set, reset, replaced, or removed:

See sheet #2 for description(s):

- All references are to San Joaquin County Surveyor's Records (S.J.C.S.R.)
- All distances shown on sheet 2 are in feet and decimals thereof.

## SURVEYOR'S STATEMENT

This Corner Record was prepared by me or under my direction in conformance with  
 the Professional Land Surveyors' Act on December 2, 2025  
 Signed *Dani Cano* P.L.S. or R.C.E. No. 9892




## COUNTY SURVEYOR'S STATEMENT

This Corner Record was received December 17, 2025  
 and examined and filed January 2, 2026  
 Signed *James E. Hart* P.L.S. or R.C.E. No. 8657  
 Title County Surveyor



County Surveyor's Comment \_\_\_\_\_

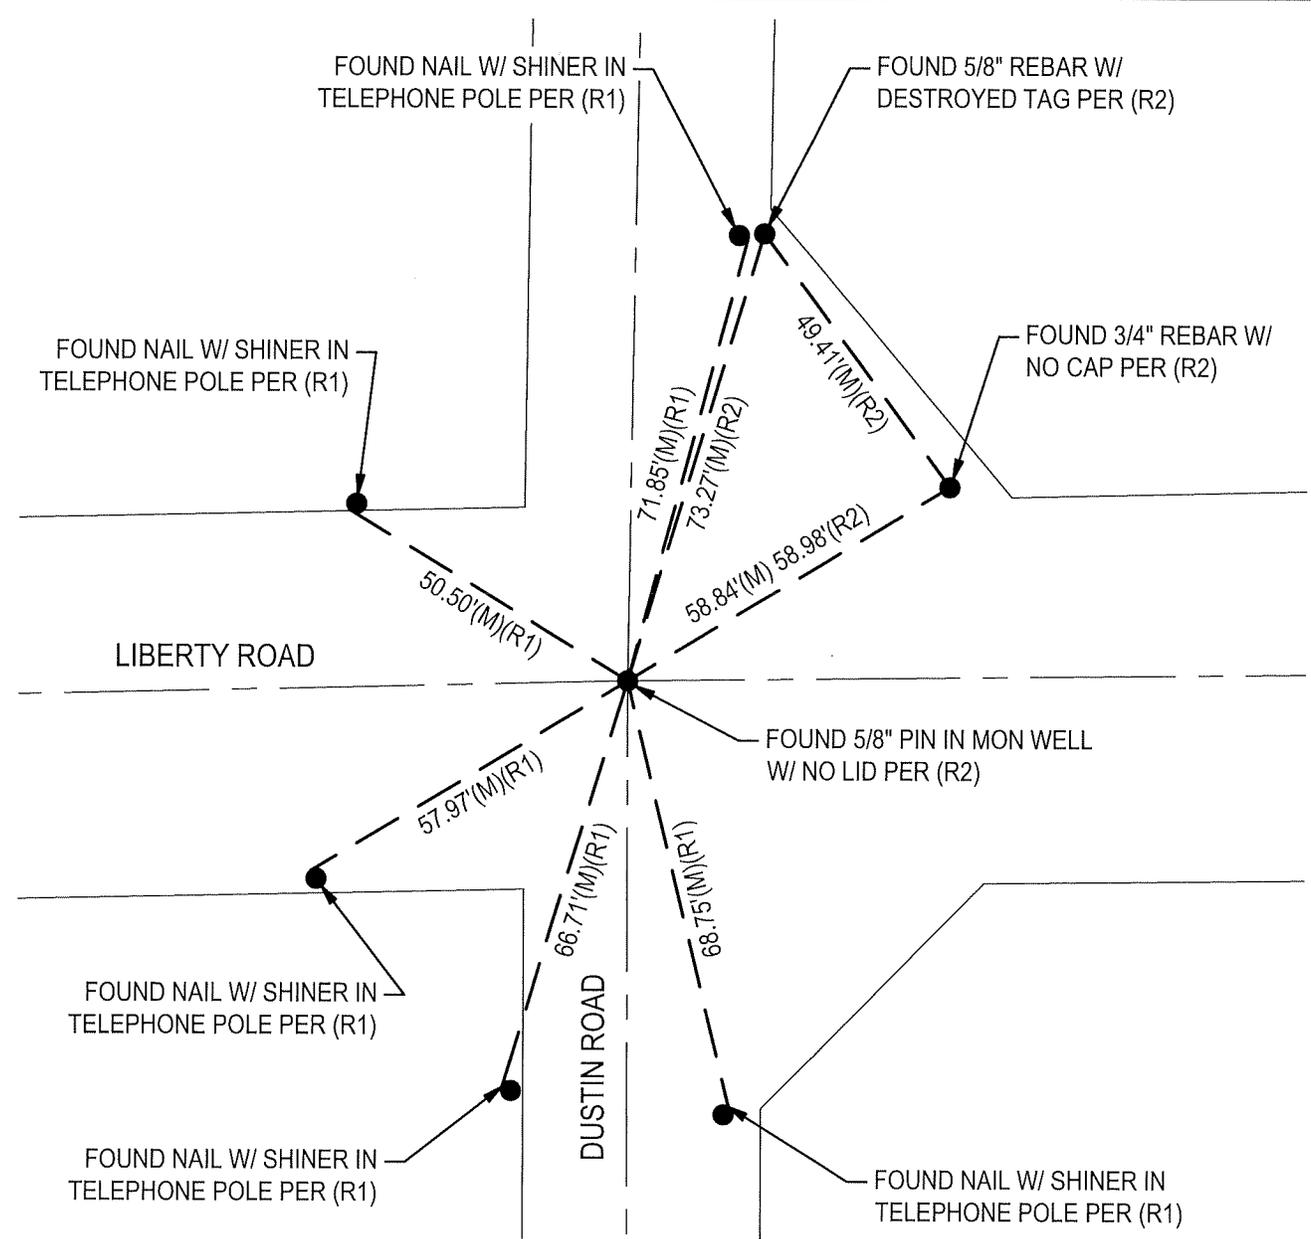

**LEGEND**

- CR CORNER RECORD
- (M) MEASURED THIS SURVEY
- S.J.C.S.R. SAN JOAQUIN COUNTY SURVEYOR'S RECORDS
- S.F.N. SEARCHED, FOUND NOTHING
- TIE LINE
- PROPERTY LINE
- FOUND MONUMENT AS NOTED
- SET MONUMENT AS NOTED

**REFERENCES**

- (R1) CR-13-121, S.J.C.S.R.
- (R2) CR-24-280, S.J.C.S.R.

**SURVEYOR'S NOTE**

THIS DOCUMENT IS BEING FILED TO COMPLY WITH THE PRE-CONSTRUCTION MONUMENT PRESERVATION REQUIREMENTS OUTLINED IN SECTION 8771 OF THE CALIFORNIA BUSINESS AND PROFESSIONS CODE. IT IS NOT THE OUTCOME OF A FINALIZED BOUNDARY SURVEY FOR ANY SPECIFIC PARCEL OF REAL PROPERTY.

