


CORNER RECORD

Agency Index CR-26-017
Document Number _____

City of LATHROP County of SAN JOAQUIN, California
Brief Legal Description PORTION OF NORTHWEST 1/4 OF SECTION 36, T.1S., R.6E., M.D.B.&M.

CORNER TYPE

COORDINATES (Optional)

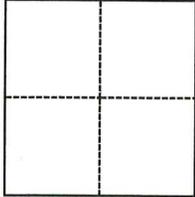

- Government Corner
- Meander
- Rancho
- Control
- Property
- Other

N. _____ E. _____
 Elevation _____
 Units Metric U.S. Survey Foot
 Horizontal Datum _____
 Zone _____ Epoch Date _____
 Vertical Datum _____
 Complies with Public Resources Code §§8801-8819
 Complies with Public Resources Code §§8890-8902

Date of Survey December 5, 2025

- PLS Act Ref.: 8765(d) 8771 8773 Other: _____
- Corner/Monument: Left as found Established Rebuilt Pre-Construction
 Found and tagged Reestablished Referenced Post-Construction

Narrative of corner identified and monument as found, set, reset, replaced, or removed:
 See sheet #2 for description(s):

THIS DOCUMENT IS FOR THE PURPOSE OF RESETTING ANY MISSING OR OBLITERATED CORNERS FOR PARCEL "A", AS SHOWN IN BOOK 26 OF SURVEYS, PAGE 96, SAN JOAQUIN COUNTY RECORDS. ALSO, NORTHWEST CORNER OF PARCEL 1, AS SHOWN IN BOOK 31 OF SURVEYS, PAGE 48, SAN JOAQUIN COUNTY RECORDS.

SURVEYOR'S STATEMENT

This Corner Record was prepared by me or under my direction in conformance with
 the Professional Land Surveyors' Act on December 18, 2025
 Signed [Signature] P.L.S. or R.C.E. No. L.S. 7600



COUNTY SURVEYOR'S STATEMENT

This Corner Record was received December 18, 2025
 and examined and filed January 2, 2026
 Signed James E. Hart P.L.S. or R.C.E. No. 8657
 Title County Surveyor



County Surveyor's Comment






WONG ENGINEERS, INC.

4578 FEATHER RIVER DRIVE, #A
STOCKTON, CA 95219

DECEMBER 18, 2025 PAGE 2 OF 2

MONUMENTS SET:

- 1 ○ 3/4" X 30" IRON PIN L.S. 7600
- 2 ○ PK NAIL W/STEEL WASHER L.S. 7600
- 3 ○ CHISELED CROSS W/BRASS TAG L.S. 7600

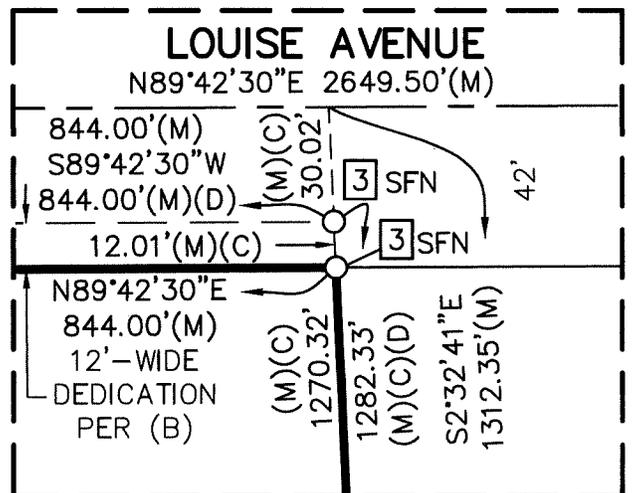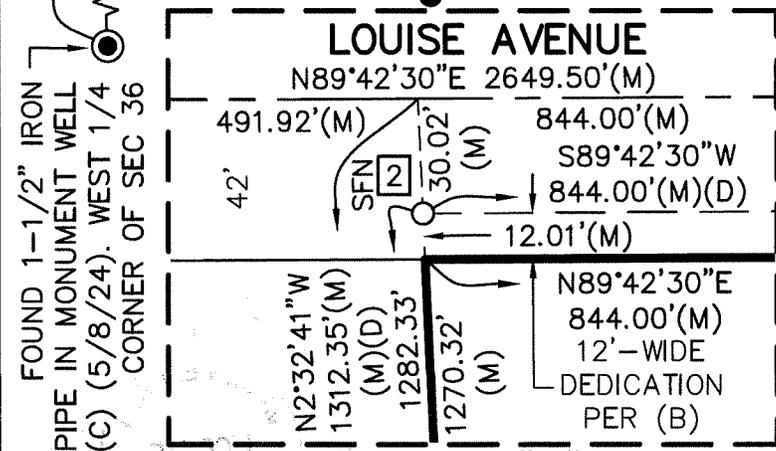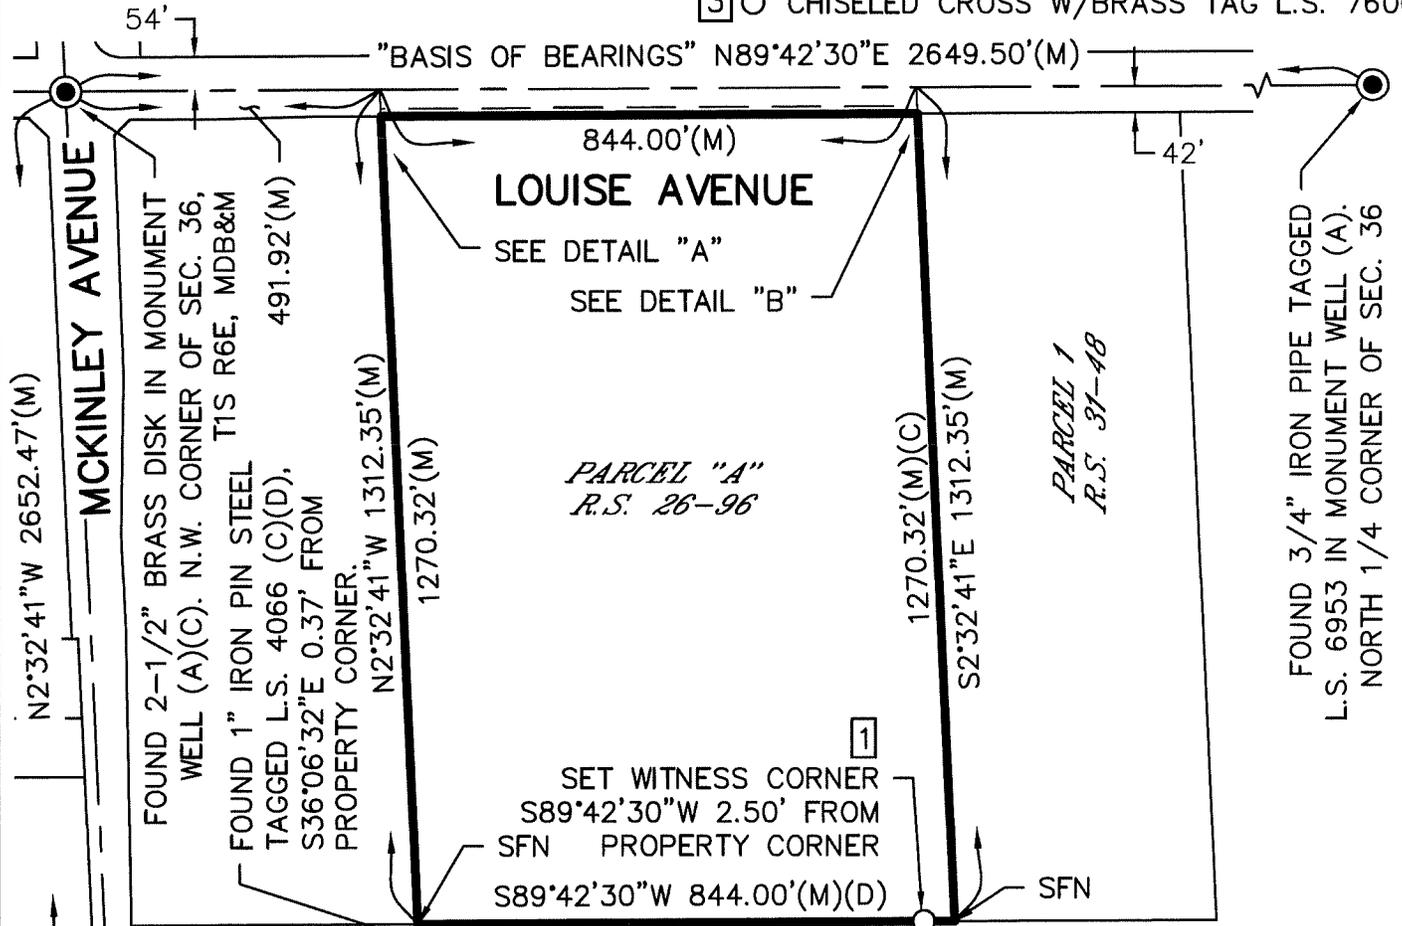

LEGEND:

- (M) MEASURED
- C.R. CORNER RECORD, BOOK-PAGE
- INST. INSTRUMENT NUMBER
- P.M. PARCEL MAP, BOOK-PAGE
- R.S. RECORD OF SURVEY, BOOK-PAGE
- SFN SEARCHED, FOUND NOTHING
- SJCR SAN JOAQUIN COUNTY RECORDS
- SJCSR SAN JOAQUIN COUNTY SURVEYOR'S RECORDS
- FOUND MONUMENT AS NOTED
- FOUND MONUMENT WELL AS NOTED

DETAIL "A"

SCALE: 1"=50'

DETAIL "B"

SCALE: 1"=50'

REFERENCES:

- (A) C.R. 11-140, SJCSR
- (B) INST. 91014479, SJCR
- (C) P.M. 11-12, SJCR
- (D) R.S. 26-96, SJCR

