

CORNER RECORD

Agency Index: CR-20-032

Document Number: _____

City of _____ County of SAN JOAQUIN, California

Brief Legal Description FOUND A CITY OF STOCKTON HORIZONTAL CONTROL MONUMENT AT THE CENTERLINE INTERSECTION OF BENJAMIN HOLT DRIVE AND HARRISBURG PLACE.



T.2N, R.6E

CORNER TYPE

- Government Corner
- Meander
- Rancho
- Control
- Property
- Other

Date of Survey 10-02-2025

COORDINATES (Optional)

N. _____ E. _____
 Elevation _____
 Units Metric U.S. Survey Foot
 Horizontal Datum _____
 Zone _____ Epoch Date _____
 Vertical Datum _____
 Complies with Public Resources Code §§8801-8819
 Complies with Public Resources Code §§8890-8902

PLS Act Ref: 8765(d) 8771 8773 Other:

Corner/Monument: Left as found Established Rebuilt Pre-Construction
 Found and Tagged Reestablished Referenced Post-Construction

Narrative of corner identified and monument as found, set, reset, replaced, or removed:

See sheet #2 for description(s):

FOUND MONUMENT AS SHOWN ON SHEET 2.

SURVEYOR'S STATEMENT

This Corner Record was prepared by me or under my direction in conformance with the Land Surveyors' Act on JANUARY 5, 2026,

Signed Tanya Cissell P.L.S. 9857 Number 9857



COUNTY SURVEYOR'S STATEMENT

This Corner Record was received January 5, 2026


and examined and filed January 9, 2026

Signed James E. Hart P.L.S. or R.C.E. No: 8657

Title County Surveyor



County Surveyor's Comment _____

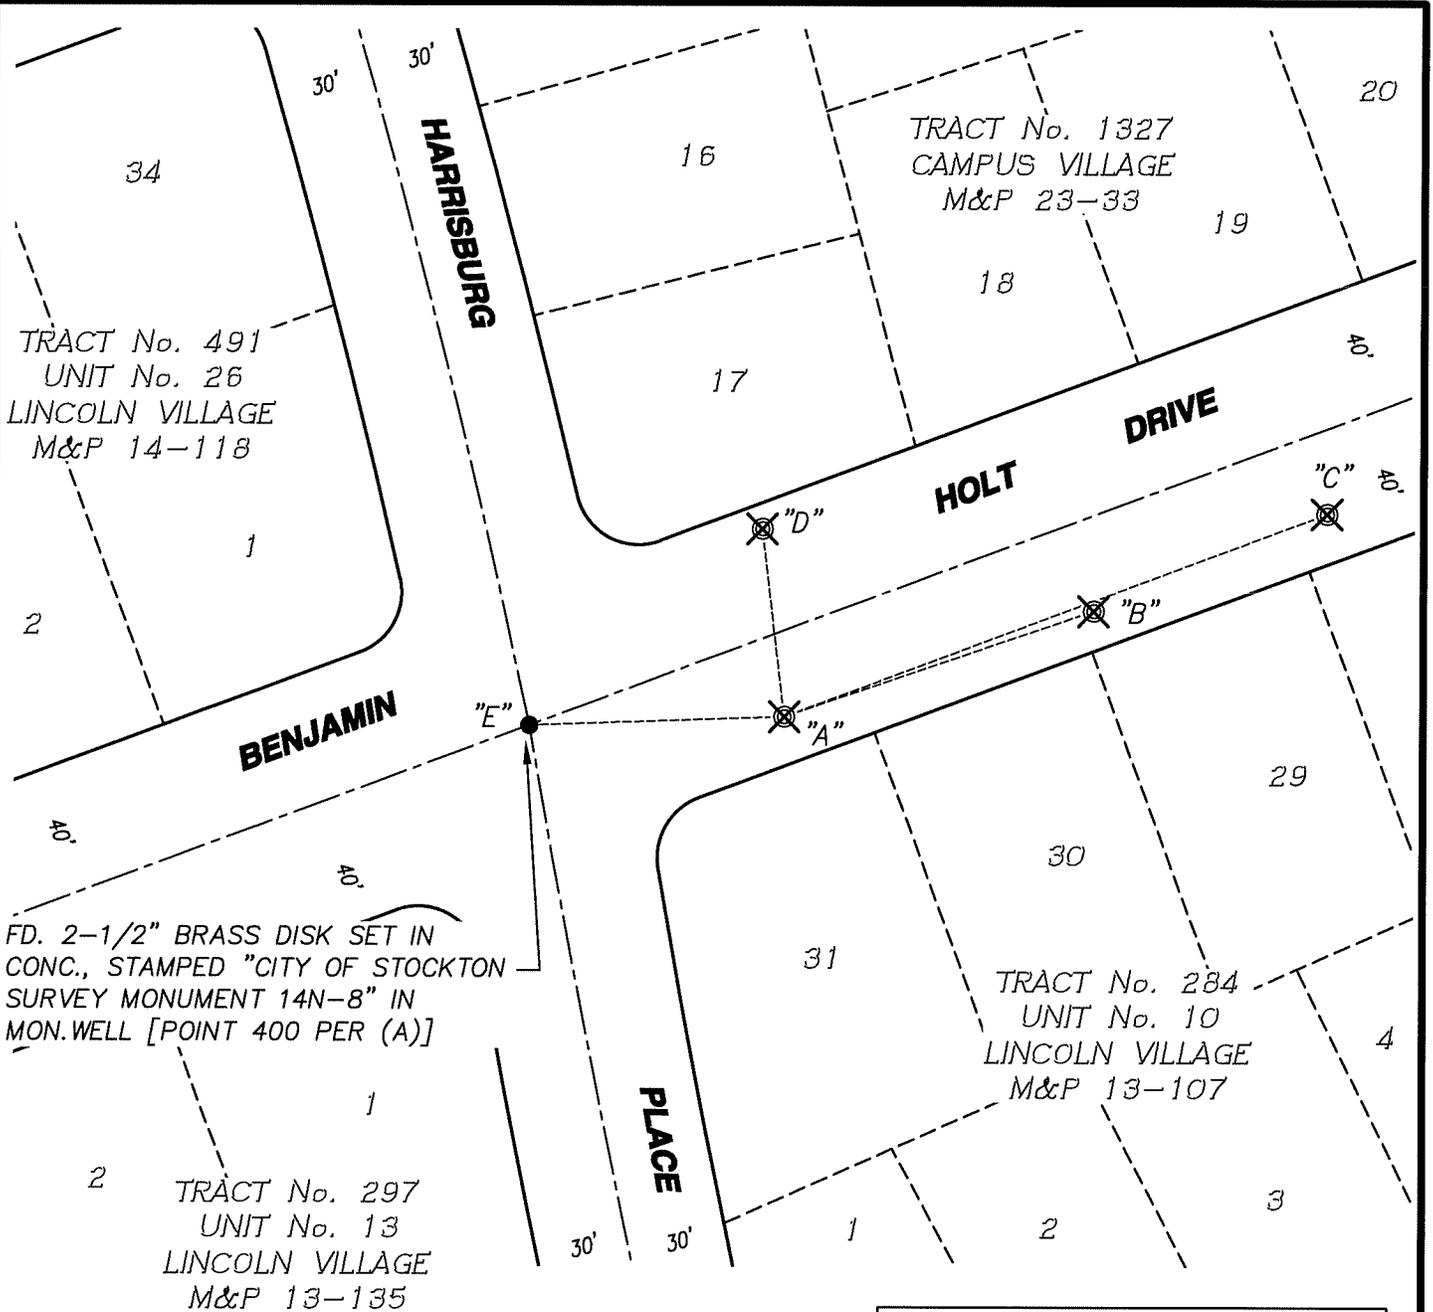

FD. 2-1/2" BRASS DISK SET IN CONC., STAMPED "CITY OF STOCKTON SURVEY MONUMENT 14N-8" IN MON. WELL [POINT 400 PER (A)]

NOTE:


THIS CORNER RECORD DOES NOT VERIFY THIS MONUMENT TO BE IN THE CORRECT POSITION.

LEGEND:

- ⊗ SET NAIL & BRASS TAG, LS 9857.
- FOUND MONUMENT AS NOTED.
- M.&P. MAPS AND PLATS, S.J.C.R.
- R.S. RECORD OF SURVEY, S.J.C.R.
- S.J.C.R. SAN JOAQUIN COUNTY RECORDS
- (M) MEASURED DISTANCE.
- MON. MONUMENT

BS-@-FS	∠	FS DISTANCE
C-A-C	00°00'00"	182.384'(M)
C-A-B	00°17'36"	103.493'(M)
C-A-D	283°40'48"	59.433'(M)
C-A-E	198°33'44"	80.407'(M)

MONUMENT	ELEVATION (NGVDxx)
"E"	7.79' (A)
"A"	7.629' (M)
"B"	7.990' (M)
"C"	8.213' (M)

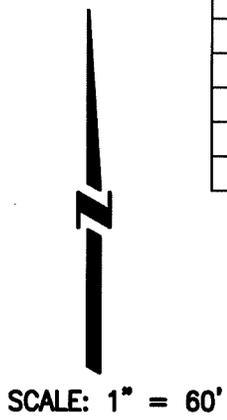

REFERENCE:

(A) R.S. 35-5, S.J.C.R.