


CORNER RECORD

Agency Index: CR-26-034

Document Number: _____

City of _____ County of SAN JOAQUIN, California

Brief Legal Description FOUND A CITY OF STOCKTON HORIZONTAL CONTROL MONUMENT AT THE NORTHWEST CORNER OF BENJAMIN HOLT DRIVE AND PERSHING AVENUE.

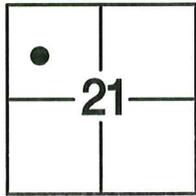

T.2N, R.6E

CORNER TYPE

- Government Corner Control
 Meander Property
 Rancho Other

Date of Survey 10-02-2025

COORDINATES (Optional)

N. _____ E. _____

Elevation _____

Units Metric U.S. Survey Foot

Horizontal Datum _____

Zone _____ Epoch Date _____

Vertical Datum _____

Complies with Public Resources Code §§8801-8819

Complies with Public Resources Code §§8890-8902

PLS Act Ref: 8765(d) 8771 8773 Other:

Corner/
 Monument: Left as found Established Rebuilt Pre-Construction
 Found and Tagged Reestablished Referenced Post-Construction

Narrative of corner identified and monument as found, set, reset, replaced, or removed:

See sheet #2 for description(s):

FOUND MONUMENT AS SHOWN ON SHEET 2.

SURVEYOR'S STATEMENT

This Corner Record was prepared by me or under my direction in conformance with the Land Surveyors' Act on JANUARY 5, 2026,

Signed Tanya Cissell P.L.S. Number 9857



COUNTY SURVEYOR'S STATEMENT

This Corner Record was received January 5, 2026


and examined and filed January 9, 2026

Signed James E. Hart P.L.S. or R.C.E. No: 8657

Title County Surveyor



County Surveyor's Comment _____

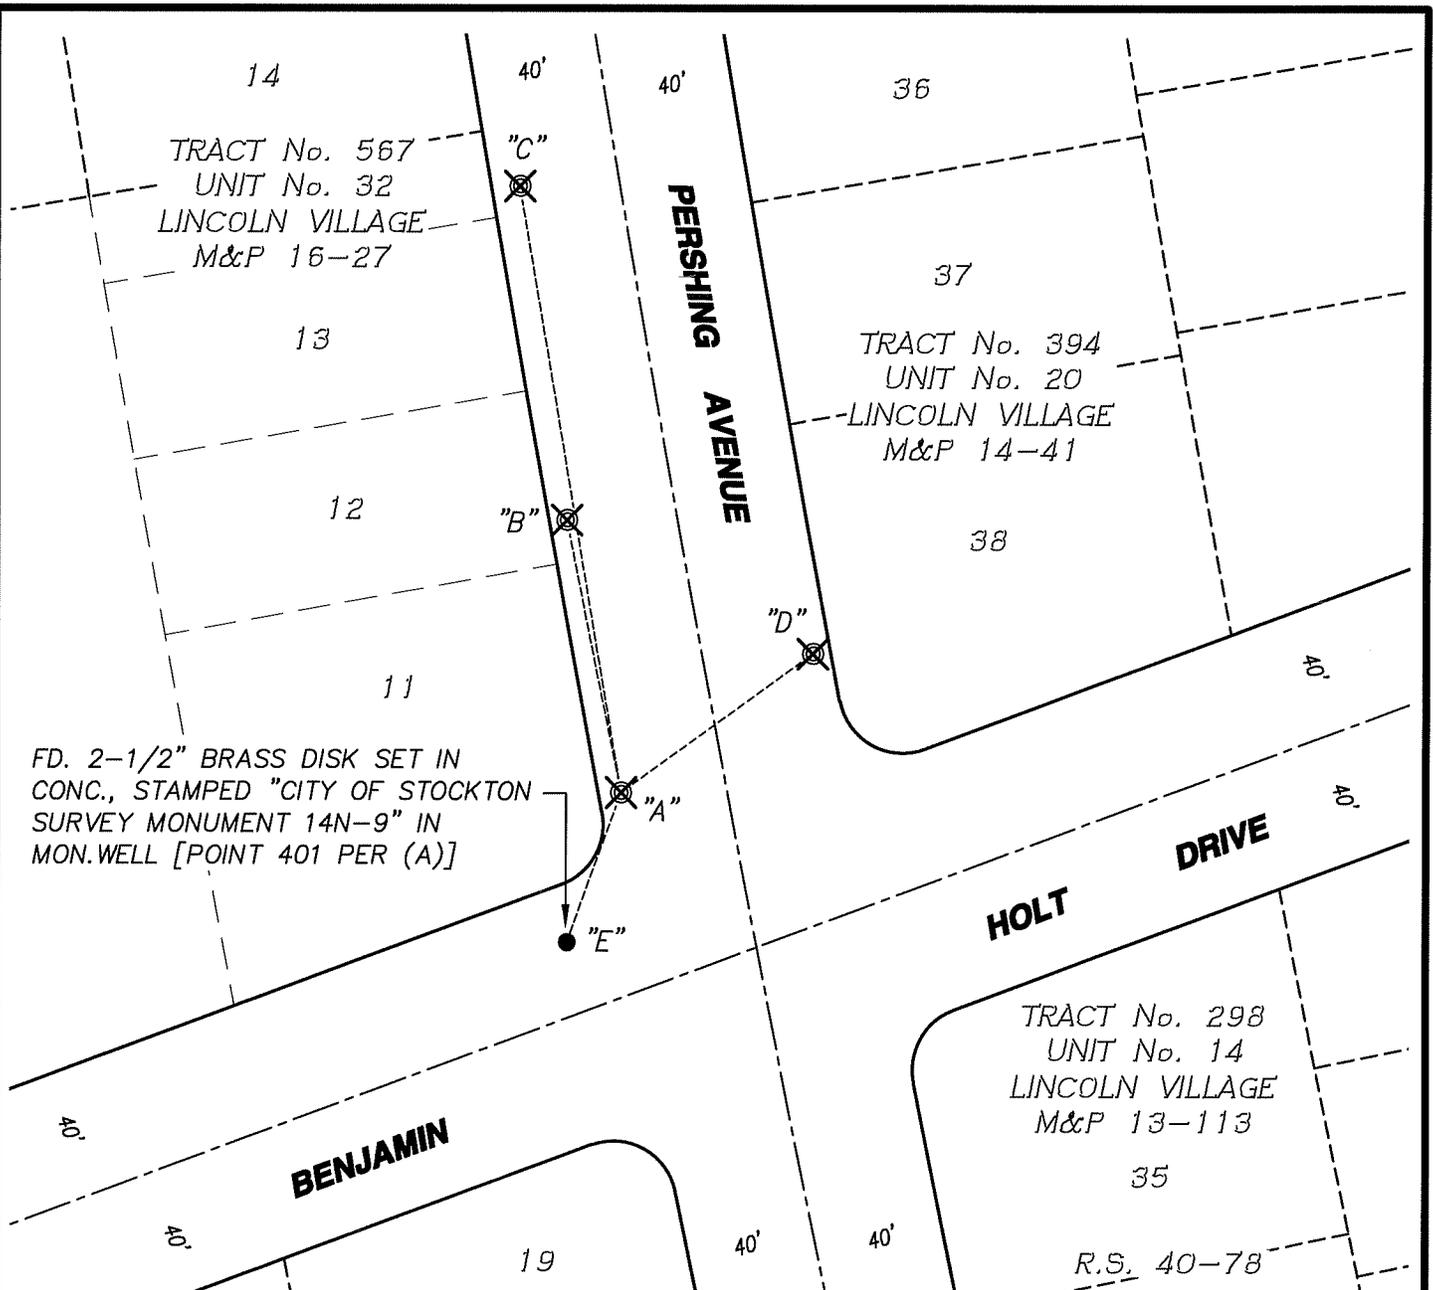

NOTE:


THIS CORNER RECORD DOES NOT VERIFY THIS MONUMENT TO BE IN THE CORRECT POSITION.

LEGEND:

- ⊗ SET NAIL & BRASS TAG, LS 9857.
- FOUND MONUMENT AS NOTED.
- M.&P. MAPS AND PLATS, S.J.C.R.
- R.S. RECORD OF SURVEY, S.J.C.R.
- S.J.C.R. SAN JOAQUIN COUNTY RECORDS
- (M) MEASURED DISTANCE.
- MON. MONUMENT

BS-@-FS	∠	FS DISTANCE
C-A-C	00°00'00"	193.20'(M)
C-A-B	359°04'17"	87.532'(M)
C-A-D	63°49'47"	74.531'(M)
C-A-E	199°53'51"	50.012'(M)

MONUMENT	ELEVATION (NGVDxx)
"E"	9.60' (A)
"A"	10.332' (M)
"B"	10.664' (M)
"C"	10.831' (M)

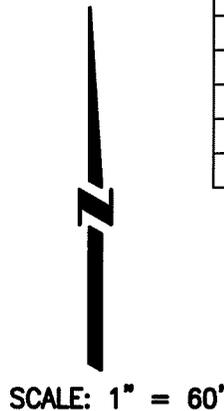

REFERENCE:

(A) R.S. 35-5, S.J.C.R.