

CORNER RECORD

Agency Index CR-26-060


Document Number _____

City of STOCKTON County of SAN JOAQUIN, California

Brief Legal Description NORTH 125' OF EAST 130' OF BLOCK 63 1/2, EAST OF CENTER STREET

CORNER TYPE

COORDINATES (Optional)

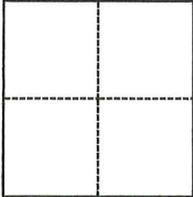

- Government Corner
- Meander
- Rancho
- Control
- Property
- Other

Date of Survey August 26, 2025

N. _____ E. _____

Elevation _____

Units Metric U.S. Survey Foot

Horizontal Datum _____

Zone _____ Epoch Date _____

Vertical Datum _____

Complies with Public Resources Code §§8801-8819

Complies with Public Resources Code §§8890-8902

PLS Act Ref.: 8765(d) 8771 8773 Other:

Corner/Monument: Left as found Established Rebuilt Pre-Construction

Found and tagged Reestablished Referenced Post-Construction

Narrative of corner identified and monument as found, set, reset, replaced, or removed:

See sheet #2 for description(s):

THIS DOCUMENT IS FOR THE PURPOSE OF RESETTING ANY MISSING OR OBLITERATED CORNERS FOR NORTH 125' OF EAST 130' OF BLOCK 63 1/2, AS SHOWN IN BOOK 34 OF SURVEYS, PAGE 24, SAN JOAQUIN COUNTY RECORDS.

SURVEYOR'S STATEMENT

This Corner Record was prepared by me or under my direction in conformance with

the Professional Land Surveyors' Act on January 9, 2026

Signed [Signature] P.L.S. or R.C.E. No. L.S. 7600



COUNTY SURVEYOR'S STATEMENT

This Corner Record was received January 13, 2026


and examined and filed January 20, 2026

Signed James E. Hart P.L.S. or R.C.E. No. 8657

Title County Surveyor

County Surveyor's Comment




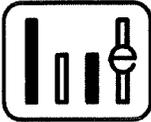

WONG ENGINEERS, INC.
 4578 FEATHER RIVER DRIVE, SUITE A
 STOCKTON, CA 95219 (209) 476-0011
 JANUARY 9, 2026 PAGE 2 OF 2

DESCRIPTION:

THIS DOCUMENT IS FOR THE PURPOSE OF
 RESETTING ANY MISSING OR OBLITERATED
 CORNERS FOR NORTH 125' OF EAST 130'
 OF BLOCK 63 1/2, AS SHOWN IN BOOK
 34 OF SURVEYS, PAGE 24, SAN JOAQUIN
 COUNTY RECORDS.

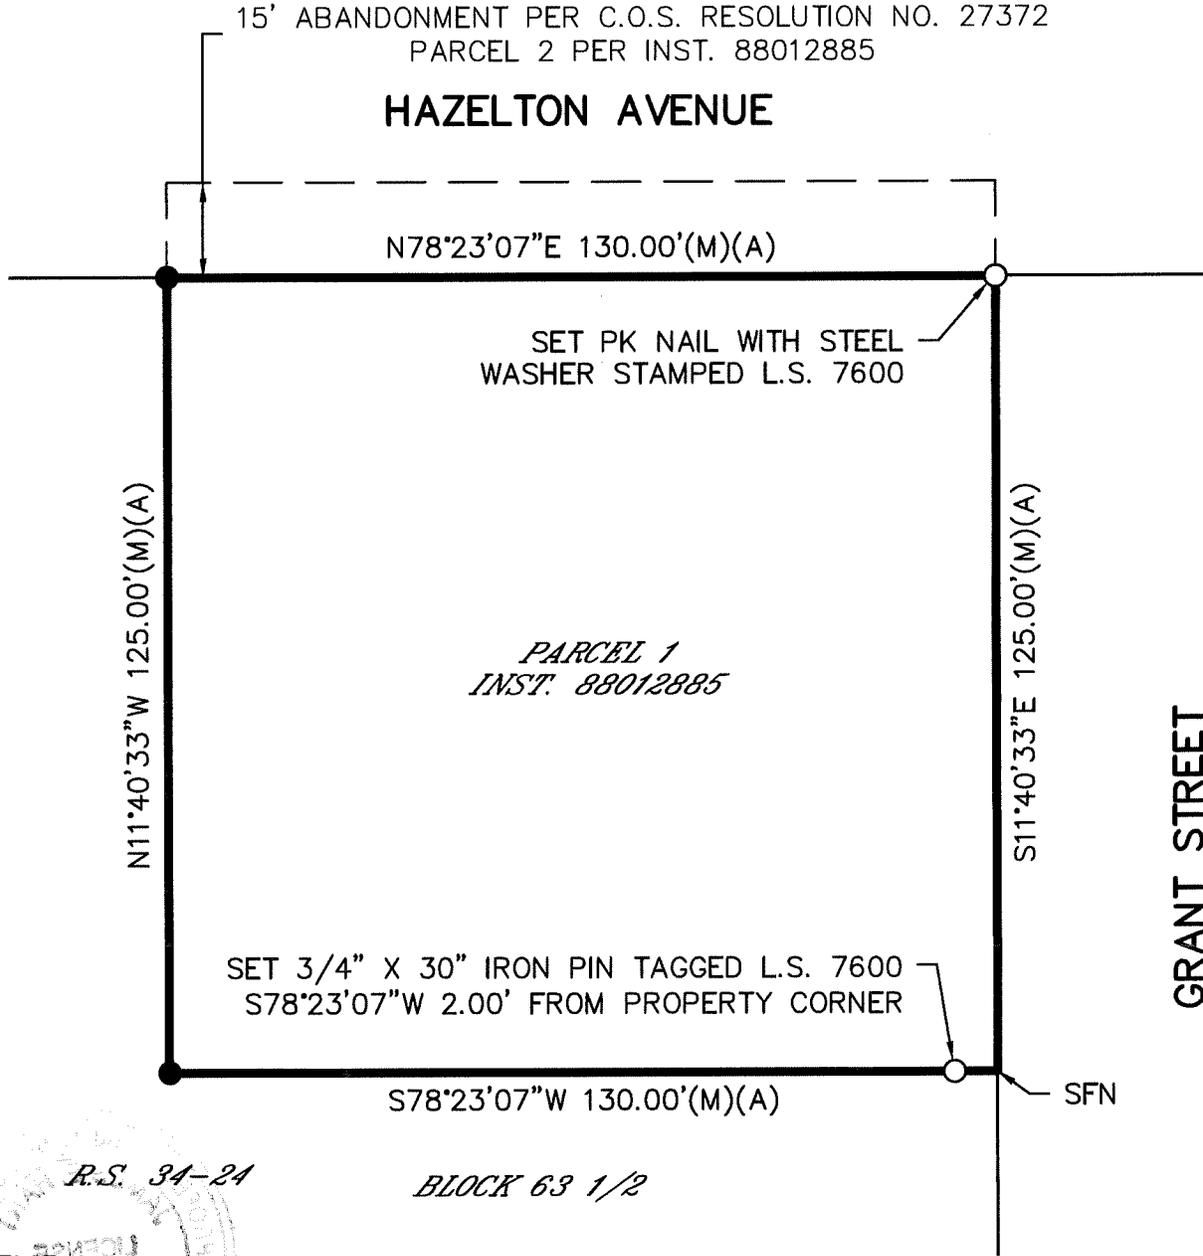

LEGEND:

- (M) MEASURED
- C.O.S. CITY OF STOCKTON
- INST. INSTRUMENT NUMBER
- R.S. RECORD OF SURVEY, BOOK-PAGE
- SFN SEARCHED, FOUND NOTHING
- SJCR SAN JOAQUIN COUNTY RECORDS

- FOUND 3/4" REBAR TAGGED L.S. 4334 (A)
- SET MONUMENT AS NOTED

REFERENCE:

(A) R.S. 34-24, SJCR

