


# CORNER RECORD

Agency Index CR-26-061  
 Document Number \_\_\_\_\_

City of STOCKTON County of San Joaquin, California  
 Brief Legal Description LOTS 7 AND 8 IN BLOCK 6, M.&P. 11-50, S.J.C.R.

### CORNER TYPE

### COORDINATES (Optional)

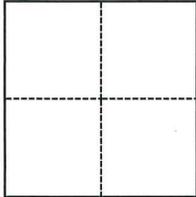

- Government Corner     Control  
 Meander                       Property  
 Rancho                             Other

Date of Survey DECEMBER 4, 2025

N. \_\_\_\_\_ E. \_\_\_\_\_  
 Elevation \_\_\_\_\_  
 Units     Metric             U.S. Survey Foot  
 Horizontal Datum \_\_\_\_\_  
 Zone \_\_\_\_\_ Epoch Date \_\_\_\_\_  
 Vertical Datum \_\_\_\_\_  
 Complies with Public Resources Code §§8801-8819  
 Complies with Public Resources Code §§8890-8902

PLS Act Ref.:     8765(d)             8771             8773             Other:  
 Corner/  
 Monument:     Left as found             Established             Rebuilt             Pre-Construction  
                      Found and tagged             Reestablished             Referenced             Post-Construction

Narrative of corner identified and monument as found, set, reset, replaced, or removed:

See sheet #2 for description(s):

### SURVEYOR'S STATEMENT

This Corner Record was prepared by me or under my direction in conformance with  
 the Professional Land Surveyors' Act on 1/12/26  
 Signed [Signature] P.L.S. or R.C.E. No. 25835




### COUNTY SURVEYOR'S STATEMENT

This Corner Record was received January 13, 2026  
 and examined and filed January 20, 2026  
 Signed James E Hart P.L.S. or R.C.E. No. 8657  
 Title County Surveyor



County Surveyor's Comment

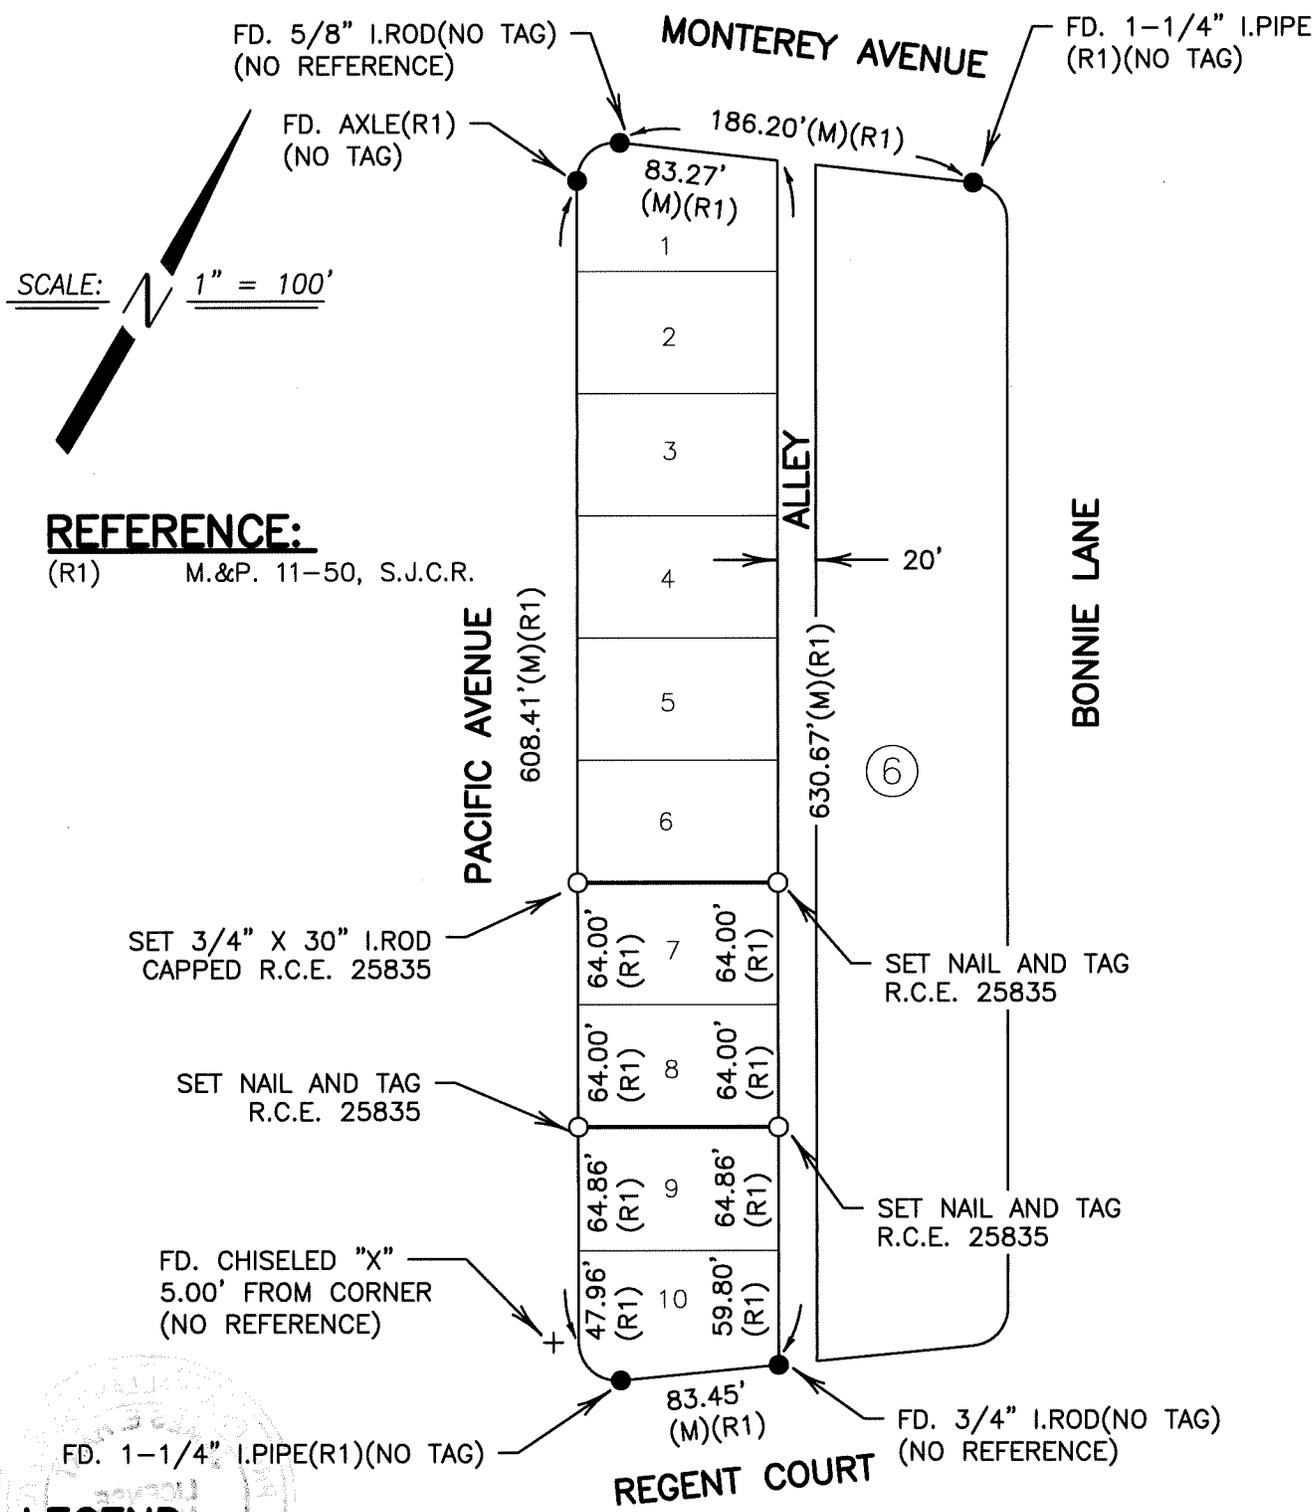

**LEGEND**

- FD. FOUND
- S.J.C.R. SAN JOAQUIN COUNTY RECORDS
- (M) MEASURED
- I.PIPE IRON PIPE
- I.ROD IRON ROD
- M.&P. MAPS AND PLATS
- FD. MONUMENT AS NOTED
- SET MONUMENT AS NOTED