

CORNER RECORD


Agency Index CR-26-060
Document Number _____

City of _____ County of San Joaquin, California

Brief Legal Description Found Monument Per Parcel "1" of Parcel Map 16-31, S.J.C.R.

CORNER TYPE

COORDINATES (Optional)

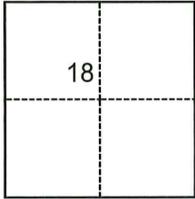

- Government Corner
- Meander
- Rancho
- Control
- Property
- Other

Date of Survey December 11, 2025

N. _____ E. _____
 Elevation _____
 Units Metric U.S. Survey Foot
 Horizontal Datum _____
 Zone _____ Epoch Date _____
 Vertical Datum _____
 Complies with Public Resources Code §§8801-8819
 Complies with Public Resources Code §§8890-8902

- PLS Act Ref.: 8765(d) 8771 8773 Other:
- Corner/Monument: Left as found Established Rebuilt Pre-Construction
 Found and tagged Reestablished Referenced Post-Construction

Narrative of corner identified and monument as found, set, reset, replaced, or removed:
 See sheet #2 for description(s):

SURVEYOR'S STATEMENT

This Corner Record was prepared by me or under my direction in conformance with
 the Professional Land Surveyors' Act on January 9, 2026
 Signed [Signature] P.L.S. or R.C.E. No. 7269




COUNTY SURVEYOR'S STATEMENT

This Corner Record was received January 13, 2026
 and examined and filed January 30, 2026
 Signed James E. Hart P.L.S. or R.C.E. No. 8657
 Title County Surveyor



County Surveyor's Comment

SCALE: N 1" = 200'

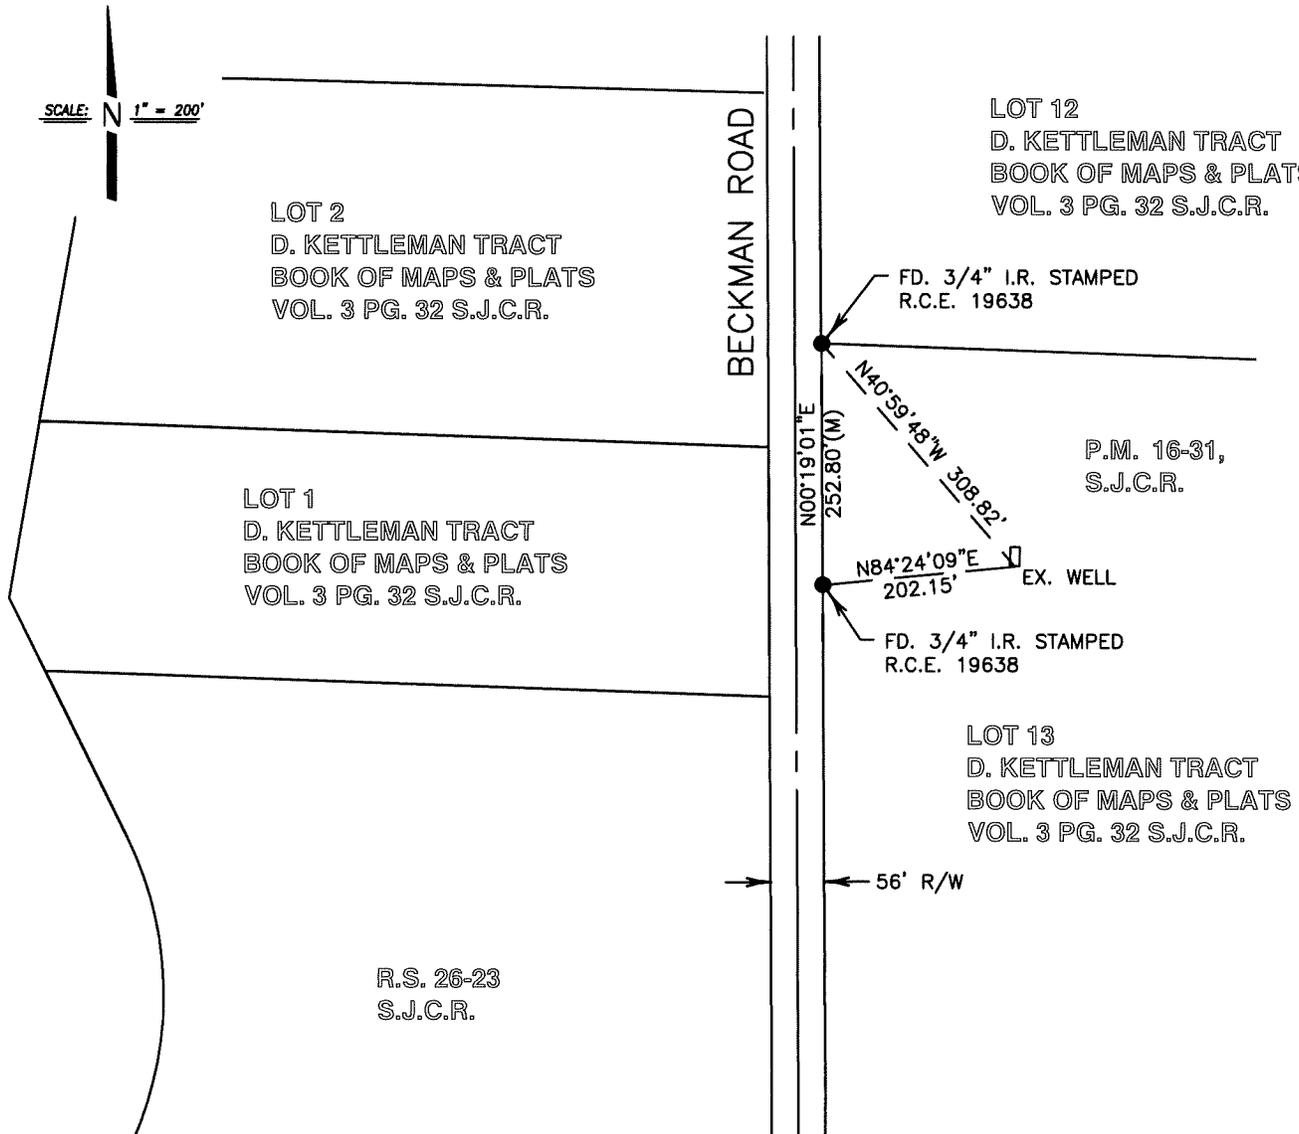

LEGEND:

- FD. FOUND
- I.R. IRON ROD
- FD. MONUMENT
- (M) MEASURED
- EX. EXISTING
- R/W RIGHT OF WAY
- S.J.C.R. SAN JOAQUIN COUNTY RECORDS
- R.S. RECORD OF SURVEY
- P.M. PARCEL MAP

DM
DILLON & MURPHY
 ENGINEERING
 847 N. CLUFF AVENUE
 SUITE A-2, LODI, CA 95240
 (209) 334-6613

S:\2023\23144\2. CAD\Corner Record.dwg Jan 08, 2026