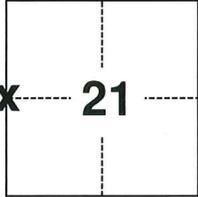


CORNER RECORD

Agency Index CR-26-068

Document Number _____

City of UNINCORPORATED County of SAN JOAQUIN, CaliforniaBrief Legal Description WEST 1/4 CORNER OF SECTION 21, T.4N., R.6E. M.D.M & PARCEL 1, 25 P.M. 72, S.J.C. RECORDS**CORNER TYPE****COORDINATES (Optional)**

- Government Corner Control
 Meander Property
 Rancho Other

N. _____ E. _____

Elevation _____

Units Metric U.S. Survey Foot

Horizontal Datum _____

Zone _____ Epoch Date _____

Vertical Datum _____

 Complies with Public Resources Code §§8801-8819 Complies with Public Resources Code §§8890-8902Date of Survey November 24, 2025

T 4N., R 6E.

PLS Act Ref.: 8765(d) 8771 8773 Other:

**Corner/
Monument:** Left as found Established Rebuilt Pre-Construction
 Found and tagged Reestablished Referenced Post-Construction

Narrative of corner identified and monument as found, set, reset, replaced, or removed:

 See sheet #2 for description(s):

FOUND 2" BRASS DISK WITH PUNCH IN MONUMENT WELL STAMPED "LS 2239" AT THE SOUTHWEST CORNER OF PARCEL 1, 25 P.M. 72, AND PER CORNER RECORD 04-015, S.J.C. RECORDS.


SURVEYOR'S STATEMENT

This Corner Record was prepared by me or under my direction in conformance with

the Professional Land Surveyors' Act on April 15, 2025Signed *R. Monson* (P.L.S. or R.C.E. No. 8474)**COUNTY SURVEYOR'S STATEMENT**This Corner Record was received January 23, 2026and examined and filed January 30, 2026Signed *James E. Hart* P.L.S. or R.C.E. No. 8657Title County Surveyor

County Surveyor's Comment _____



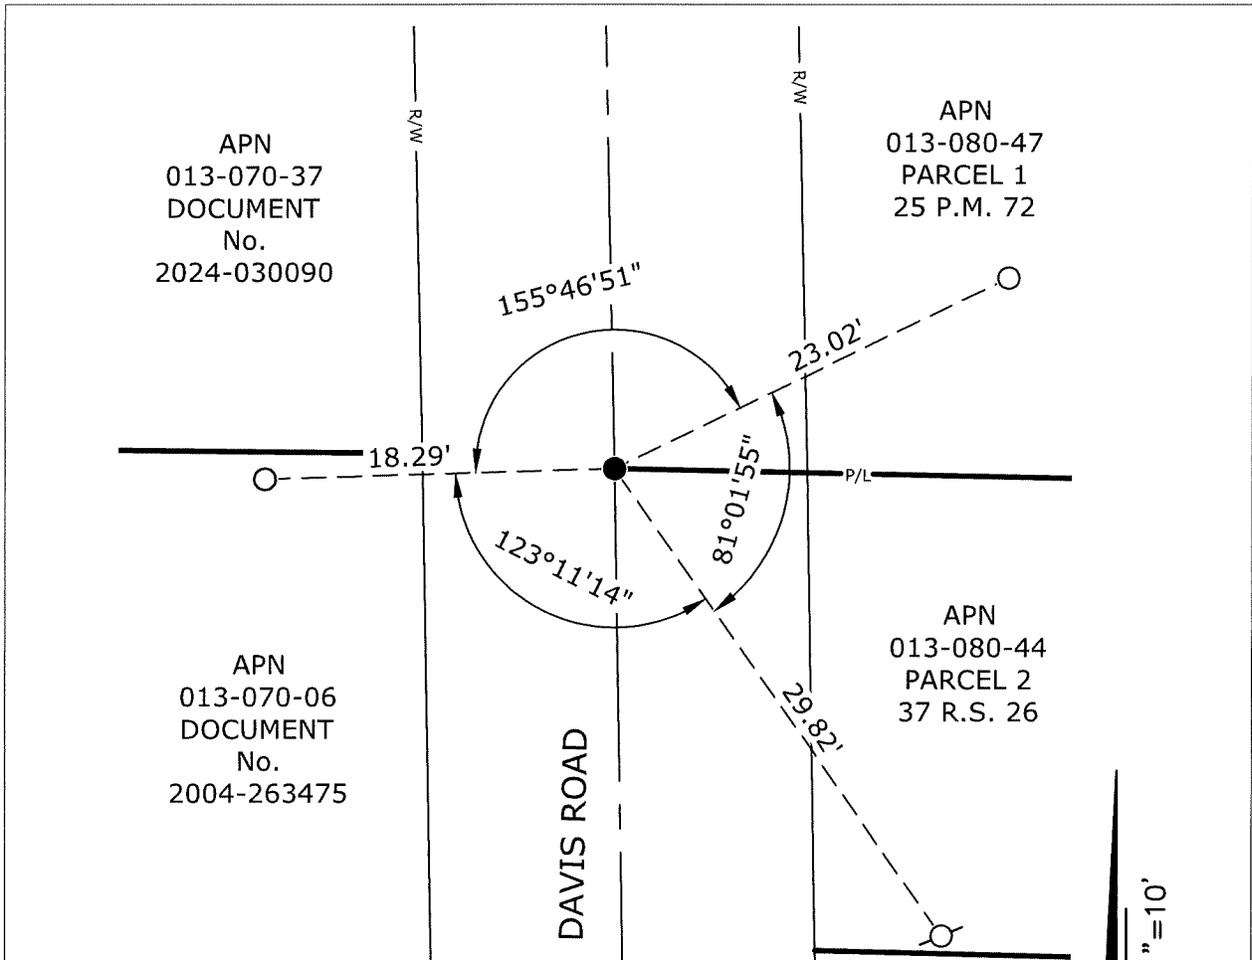

APN
013-070-37
DOCUMENT
No.
2024-030090

APN
013-080-47
PARCEL 1
25 P.M. 72

APN
013-070-06
DOCUMENT
No.
2004-263475

APN
013-080-44
PARCEL 2
37 R.S. 26

APN
013-080-43
PARCEL 1
37 R.S. 26

LEGEND:


- FOUND 2" BRASS DISK WITH PUNCH IN MONUMENT WELL STAMPED "LS 2239"
- SET DIMPLED SPIKE STAMPED "SURVEY MARK"
- ⊗ SET 5/8" REBAR WITH CAP
- S.J.C.R. SAN JOAQUIN COUNTY RECORDS
- S.J.C.S.R. SAN JOAQUIN COUNTY SURVEYOR RECORDS

APN ASSESSOR'S PARCEL NUMBER
R.S. RECORD OF SURVEY
P.M. PARCEL MAP

REFERENCE(S):

CORNER RECORD 04-015, S.J.C.S.R.
25 P.M. 72, S.J.C.R.

NOTE: THE PURPOSE OF THIS CORNER RECORD IS TO PERPETUATE THE POSITION(S) OF EXISTING MONUMENT(S). NO REPRESENTATION IS MADE TO ANY RELATIVE POSITION(S) OF SAID MONUMENT(S). ALL RIGHT OF WAY, PROPERTY LINES, CENTERLINES AND OTHERS ARE FOR GRAPHICAL REPRESENTATION ONLY.

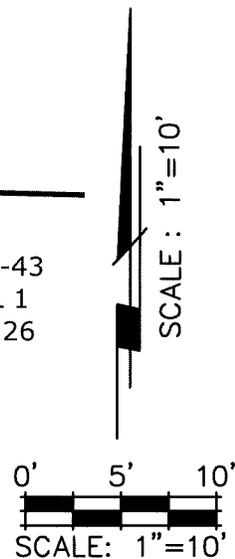

905 Sutter St., Suite 200, Folsom, CA 95630
(916) 366-3040 Fax (916) 366-3303
R. E. Y. ENGINEERS, Inc.
Civil Engineers / Land Surveyors

**CORNER RECORD
EXHIBIT MAP**

SCALE: 1" = 10'
JOB NO: 35672800
DATE: 1/6/2026
DWG: 35672800.dwg