


CORNER RECORD

Agency Index CR-26-074
Document Number _____

City of Stockton County of San Joaquin, California
Brief Legal Description Monument found along Channel Street per 14-PM-74, S.J.C.R.

CORNER TYPE

COORDINATES (Optional)

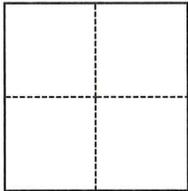

- Government Corner
- Meander
- Rancho
- Control
- Property
- Other

Date of Survey March 12, 2025

N. _____ E. _____

Elevation _____

Units Metric U.S. Survey Foot

Horizontal Datum _____

Zone _____ Epoch Date _____

Vertical Datum _____

Complies with Public Resources Code §§8801-8819

Complies with Public Resources Code §§8890-8902

X
Block 72, East of Center St.

- PLS Act Ref.: 8765(d) 8771 8773 Other:
- Corner/Monument: Left as found Established Rebuilt Pre-Construction
 Found and tagged Reestablished Referenced Post-Construction

Narrative of corner identified and monument as found, set, reset, replaced, or removed:

See sheet #2 for description(s):

SURVEYOR'S STATEMENT

This Corner Record was prepared by me or under my direction in conformance with
the Professional Land Surveyors' Act on January 19th, 2026
Signed [Signature] P.L.S. or R.C.E. No. PLS 8366




COUNTY SURVEYOR'S STATEMENT

This Corner Record was received January 26, 2026
and examined and filed February 17, 2026
Signed James E. Hart P.L.S. or R.C.E. No. 8657
Title County Surveyor



County Surveyor's Comment

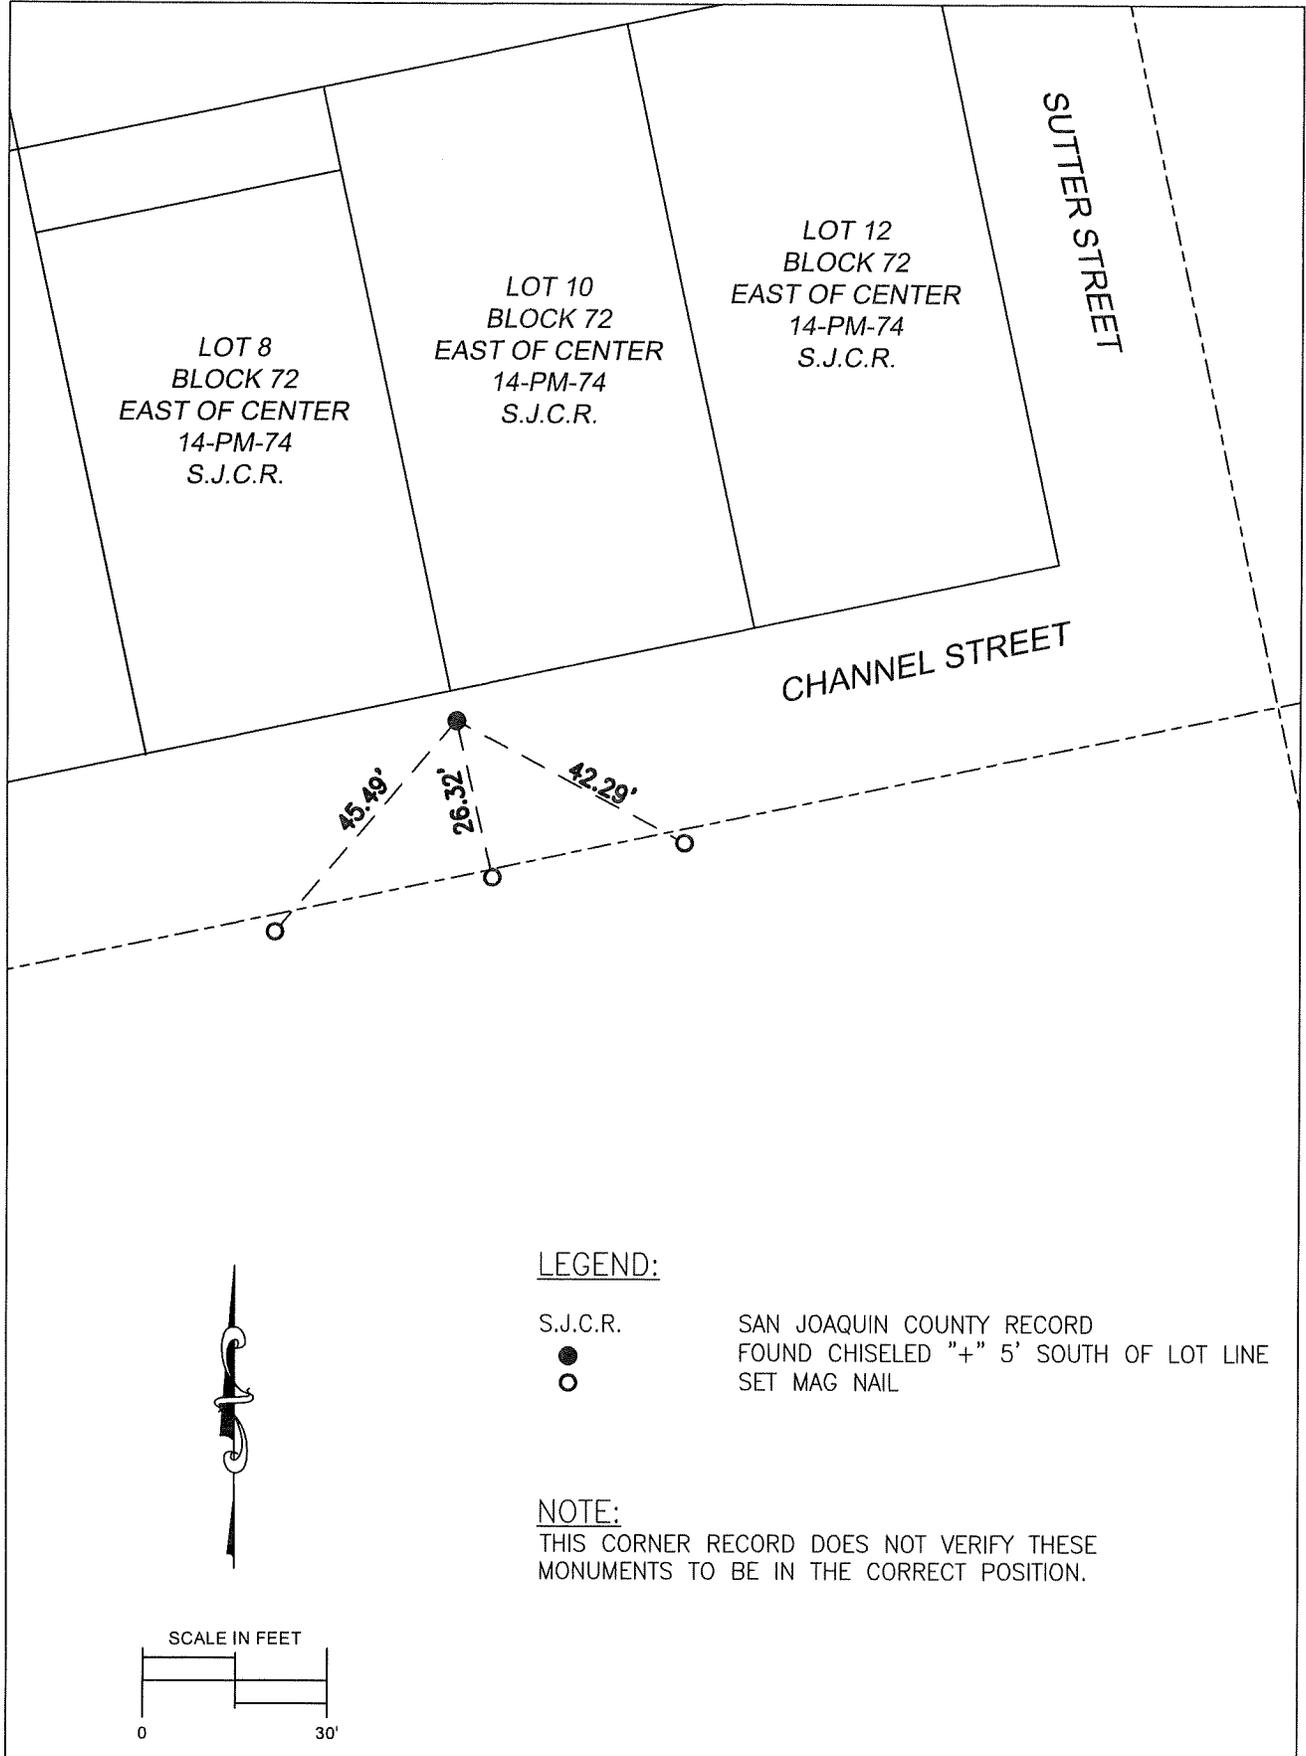

LEGEND:

S.J.C.R.



SAN JOAQUIN COUNTY RECORD
 FOUND CHISELED "+" 5' SOUTH OF LOT LINE
 SET MAG NAIL

NOTE:

THIS CORNER RECORD DOES NOT VERIFY THESE
 MONUMENTS TO BE IN THE CORRECT POSITION.

