


CORNER RECORD

Agency Index CR-26-080
Document Number _____

City of _____ County of SAN JOAQUIN, California
Brief Legal Description MONUMENT AT THE CENTERLINE INTERSECTION OF MOURFIELD AVENUE & CLAYTON AVENUE

CORNER TYPE

COORDINATES (Optional)

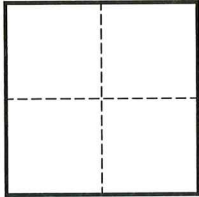

- Government Corner
- Meander
- Rancho
- Control
- Property
- Other

N. _____ E. _____
 Elevation _____
 Units Metric U.S. Survey Foot
 Horizontal Datum _____
 Zone _____ Epoch Date _____
 Vertical Datum _____

Date of Survey DECEMBER 22, 2025

- Complies with Public Resources Code §§8801-8819
- Complies with Public Resources Code §§8890-8902

PLS Act Ref.: 8765(d) 8771 8773 Other:
 Corner/Monument: Left as found Established Rebuilt Pre-Construction
 Found and tagged Reestablished Referenced Post-Construction

Narrative of corner identified and monument as found, set, reset, replaced, or removed:

See sheet #2 for description(s):

FOUND REBAR AND BRASS TAG STAMPED "SJCO PUB WORKS", IN MONUMENT WELL, AT THE CENTERLINE INTERSECTION OF MOURFIELD AVENUE & CLAYTON AVENUE, PER CR-11-178, SAN JOAQUIN COUNTY SURVEYOR'S RECORDS.

MONUMENT WAS REFERENCED PRIOR TO THE START OF CONSTRUCTION PROJECT IN THE VICINITY.

SURVEYOR'S STATEMENT

This Corner Record was prepared by me or under my direction in conformance with

the Professional Land Surveyors' Act on 2/10/26

Signed  P.L.S. or R.C.E. No. 9592



COUNTY SURVEYOR'S STATEMENT

This Corner Record was received February 12, 2026

and examined and filed February 23, 2026


Signed  P.L.S. or R.C.E. No. 8657

Title County Surveyor



County Surveyor's Comment

Empty dashed box for County Surveyor's Comment.

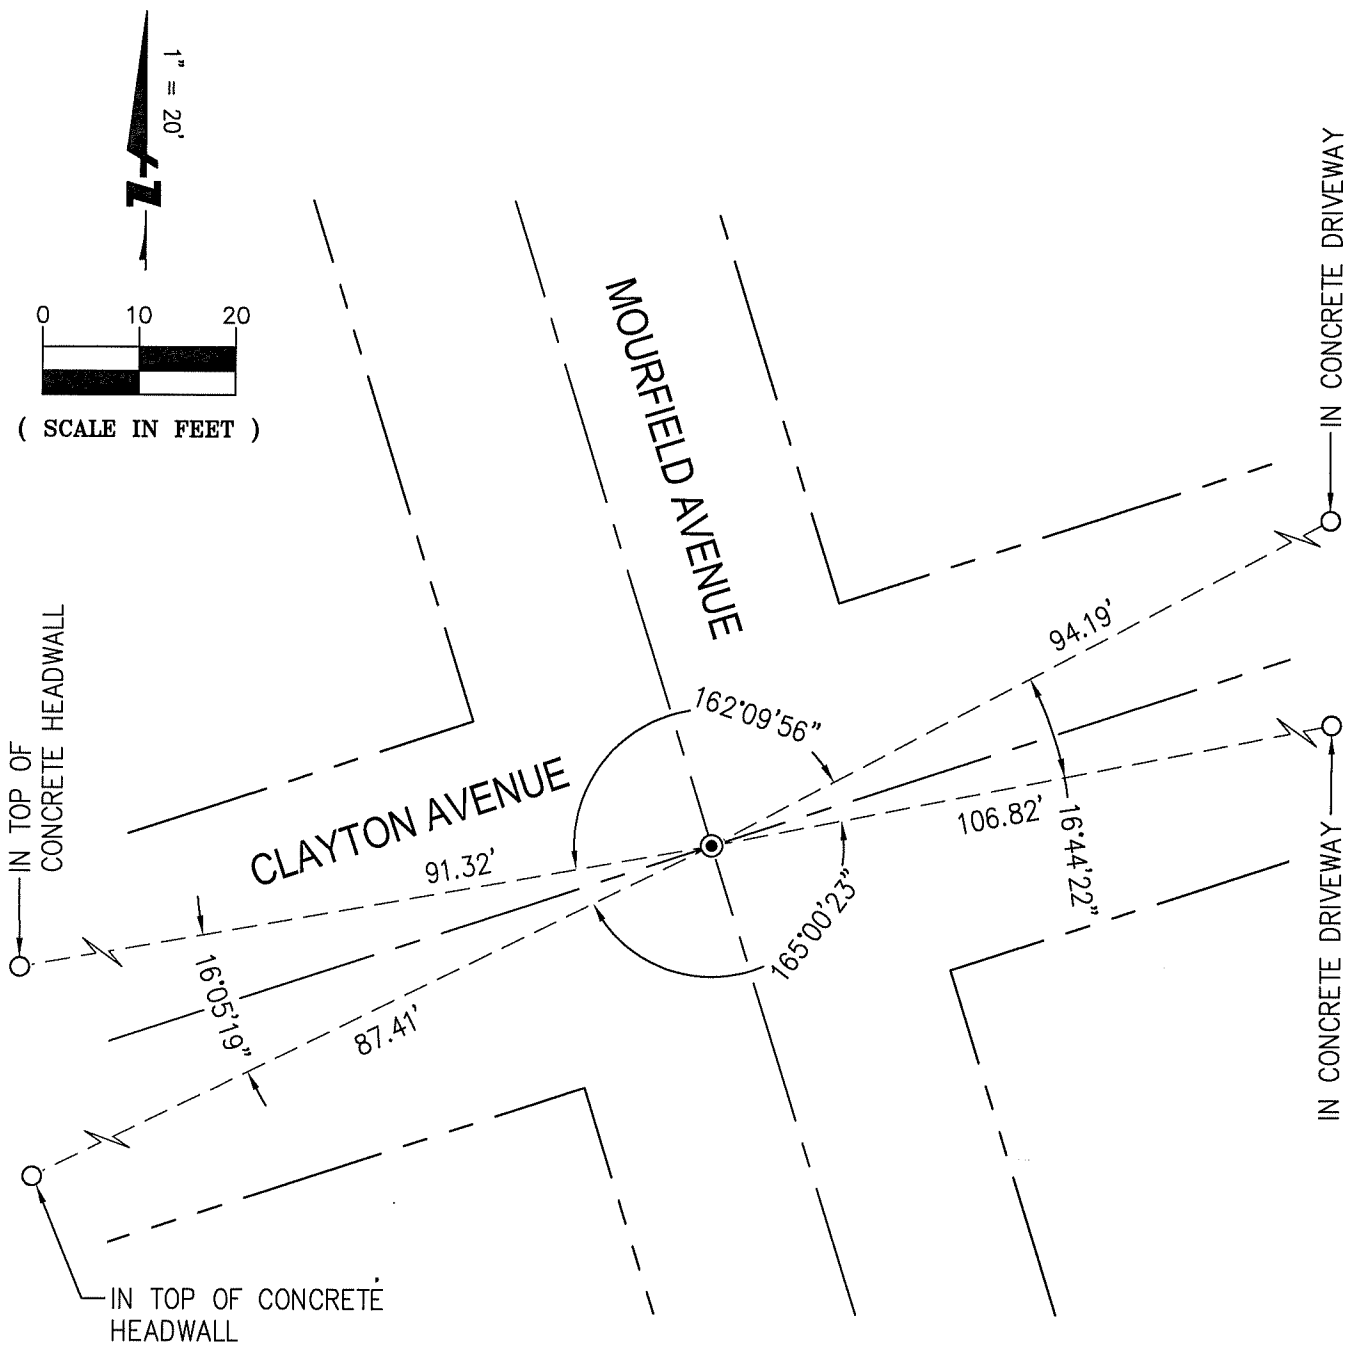

LEGEND

- ⊙ FOUND REBAR AND BRASS TAG STAMPED "SJCO PUB WORKS", IN MONUMENT WELL, AT THE CENTERLINE INTERSECTION OF MOURFIELD AVENUE & CLAYTON AVENUE, PER CR-11-178, SAN JOAQUIN COUNTY SURVEYOR'S RECORDS.
- SET MAG NAIL & WASHER STAMPED "BKF CONTROL" AS NOTED

BKF
 1730 N. FIRST STREET
 SUITE 600
 SAN JOSE, CA 95112
 (408) 467-9100
 www.bkf.com

SUBJECT PRE-CONSTRUCTION CORNER RECORD
MOURFIELD AVENUE AND CLAYTON AVENUE
 JOB NO. 20191483 - MON PRESERVATION
 BY RDV APPR. JML DATE 12-19-2025