


CORNER RECORD

Agency Index CR-26-091
Document Number _____

City of STOCKTON County of SAN JOAQUIN, California
Brief Legal Description WITNESS CORNER AT THE SE CORNER OF N MADISON ST AND WEST HARDING WAY

CORNER TYPE

COORDINATES (Optional)

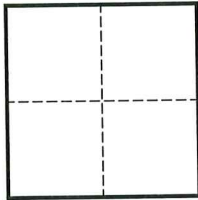

- Government Corner
- Meander
- Rancho
- Control
- Property
- Other

Date of Survey JULY 29, 2025

N. _____ E. _____
 Elevation _____
 Units Metric U.S. Survey Foot
 Horizontal Datum _____
 Zone _____ Epoch Date _____
 Vertical Datum _____
 Complies with Public Resources Code §§8801-8819
 Complies with Public Resources Code §§8890-8902

PLS Act Ref.: 8765(d) 8771 8773 Other:
 Corner/Monument: Left as found Established Rebuilt Pre-Construction
 Found and tagged Reestablished Referenced Post-Construction

Narrative of corner identified and monument as found, set, reset, replaced, or removed:

See sheet #2 for description(s):

FOUND MAG NAIL AND BRASS TAG, STAMPED "L.S. 7126", PER BOOK 39 OF SURVEYS AT PAGE 98, SAN JOAQUIN COUNTY RECORDS

MONUMENT WAS REFERENCED PRIOR TO THE START OF CONSTRUCTION PROJECT IN THE VICINITY BY WEST VALLEY CONSTRUCTION COMPANY.

SURVEYOR'S STATEMENT

This Corner Record was prepared by me or under my direction in conformance with the Professional Land Surveyors' Act on AUGUST 6, 2025

Signed [Signature] P.L.S. or R.C.E. No. 9592



COUNTY SURVEYOR'S STATEMENT

This Corner Record was received February 12, 2026
and examined and filed February 24, 2026


Signed James E Hart P.L.S. or R.C.E. No. 8657

Title County Surveyor



County Surveyor's Comment

[Empty dashed box for County Surveyor's Comment]

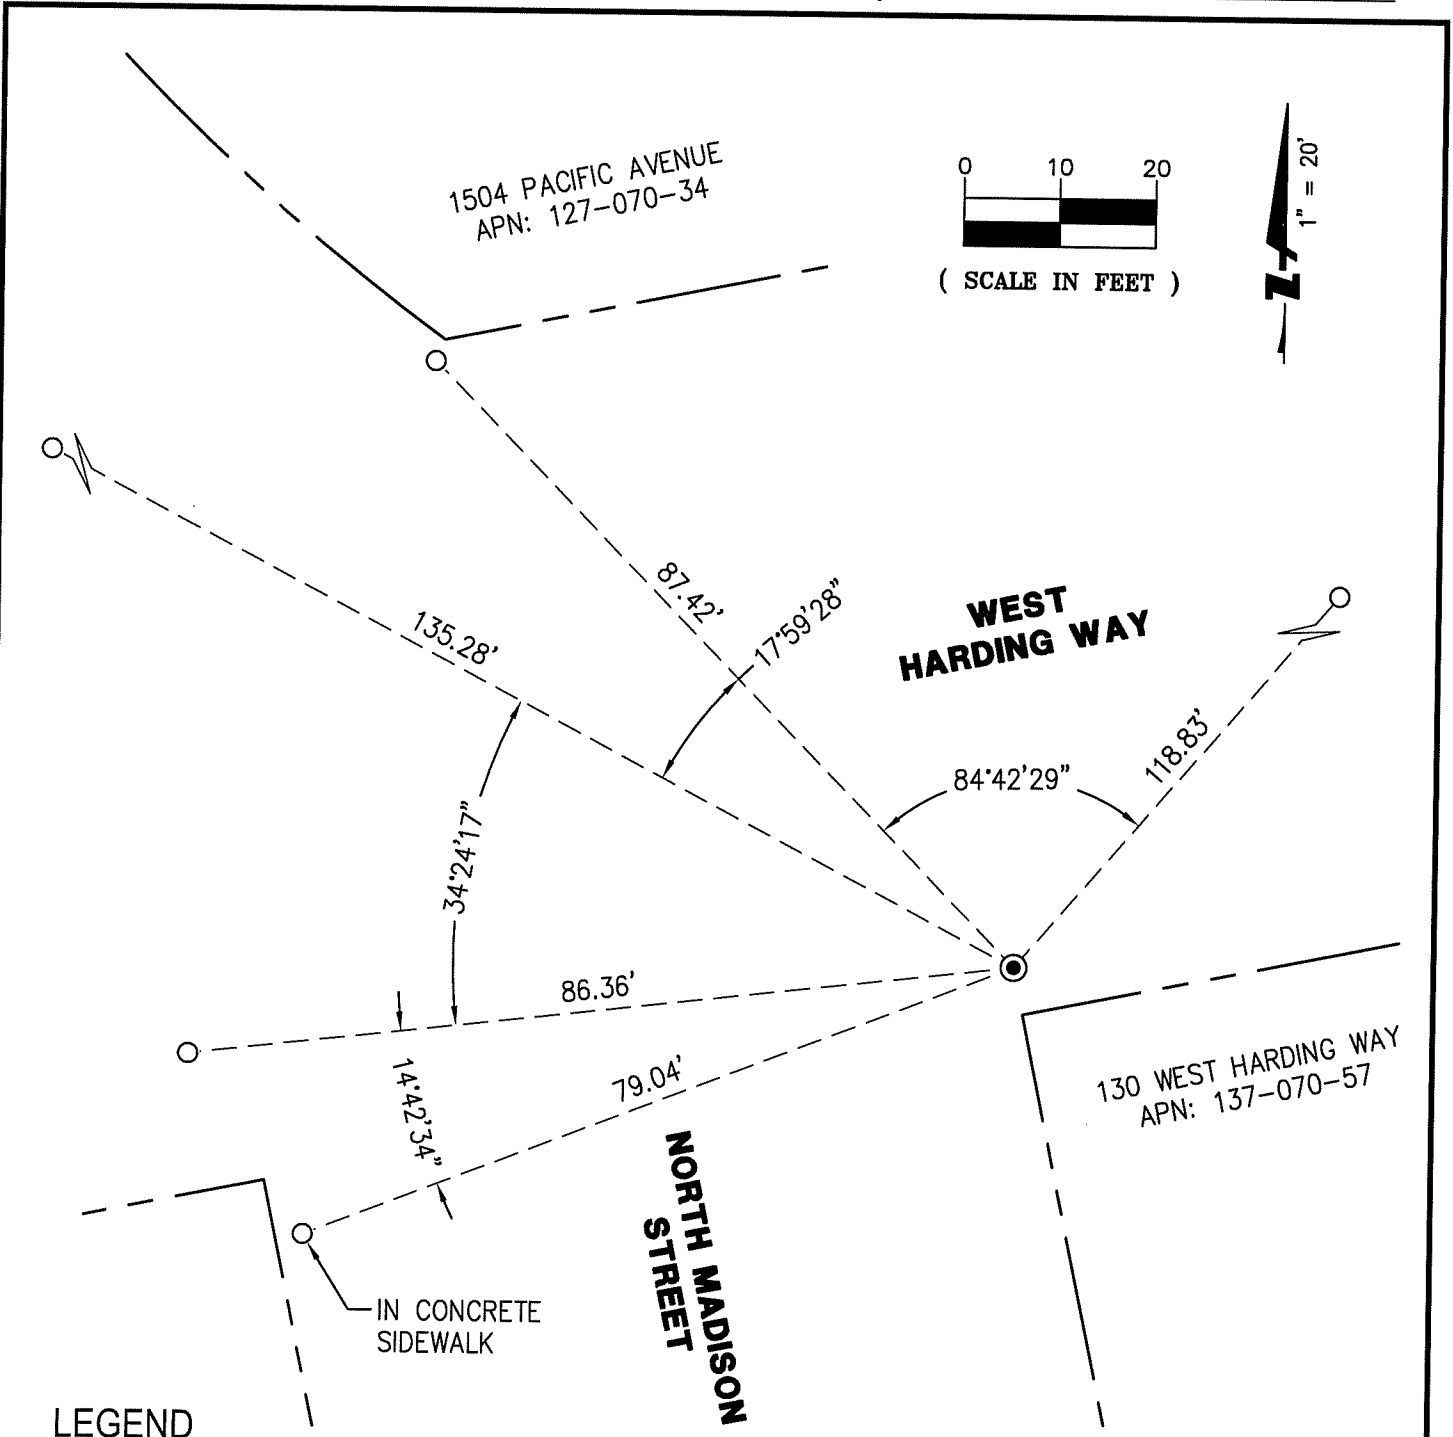

LEGEND

- FOUND MAG NAIL AND BRASS TAG, STAMPED "L.S. 7126", PER BOOK 39 OF SURVEYS AT PAGE 98, SAN JOAQUIN COUNTY RECORDS
- SET MAG NAIL & WASHER IN TOP OF CONCRETE CURB UNLESS OTHERWISE NOTED
- APN ASSESSOR'S PARCEL NUMBER

BKF
 1730 N. FIRST STREET
 SUITE 600
 SAN JOSE, CA 95112
 (408) 467-9100
 www.bkf.com

SUBJECT **PRE-CONSTRUCTION CORNER RECORD**
WITNESS CORNER AT THE SE CORNER OF
WEST HARDING WAY AND N MADISON STREET
 JOB NO. 20191483 - MON PRESERVATION
 BY RDV APPR. GA DATE 8/6/2025

K:\2019\1483_LINCO-HOL_PRES_SURV\DWG\427_SJK-24C_HARDING-427_OR_SJK-24C_PRES.DWG