


CORNER RECORD

Agency Index CR-26-109
Document Number _____

City of STOCKTON County of SAN JOAQUIN, California
Brief Legal Description APN 141-050-39, LOTS 1, 2, AND 3, BLOCK 2, M.&P. 9-22, S.J.C.R.

CORNER TYPE

COORDINATES (Optional)

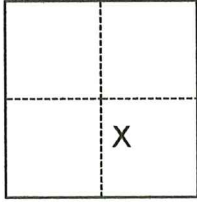

- Government Corner
- Meander
- Rancho
- Control
- Property
- Other

N. _____ E. _____
Elevation _____
Units Metric U.S. Survey Foot
Horizontal Datum _____
Zone _____ Epoch Date _____
Vertical Datum _____
 Complies with Public Resources Code §§8801-8819
 Complies with Public Resources Code §§8890-8902

Date of Survey January 27, 2026

SEC. 31 C.M. WEBER GRANT

- PLS Act Ref.: 8765(d) 8771 8773 Other:
- Corner/Monument: Left as found Established Rebuilt Pre-Construction
 Found and tagged Reestablished Referenced Post-Construction

Narrative of corner identified and monument as found, set, reset, replaced, or removed:
 See sheet #2 for description(s):

SEE SHEET 2 OF 2 FOR MONUMENTS FOUND AND SET.

SURVEYOR'S STATEMENT

This Corner Record was prepared by me or under my direction in conformance with
the Professional Land Surveyors' Act on 02/27/2026
Signed Walter John Shoup P.L.S. or R.C.E. No. L-7736



COUNTY SURVEYOR'S STATEMENT

This Corner Record was received March 3, 2026
and examined and filed March 13, 2026
Signed James E. Hart P.L.S. or R.C.E. No. 8657
Title County Surveyor




County Surveyor's Comment

ABBREVIATIONS:

CHW CHAS. H. WIDDOWS SURVEY
 D.N. DOCUMENT NUMBER, S.J.C.R.
 FD. FOUND
 (M) MEASURED
 M.&P. MAPS AND PLATS, S.J.C.R.
 MON. MONUMENT
 PLS PROFESSIONAL LAND SURVEYOR
 REF. REFERENCE
 RRS RAILROAD SPIKE
 S.F.N. SEARCHED FOUND NOTHING
 S.J.CO SAN JOAQUIN COUNTY
 S.J.C.R. SAN JOAQUIN COUNTY RECORDS
 S.J.C.S.R. SAN JOAQUIN COUNTY SURVEYOR'S RECORDS

REFERENCES:

(R1) CHW EE-115, S.J.C.S.R.
 (R2) M.&P. 9-22, S.J.C.R.
 (R3) M.&P. 10-10, S.J.C.R.
 (D1) D.N. 2024-028955, S.J.C.R.


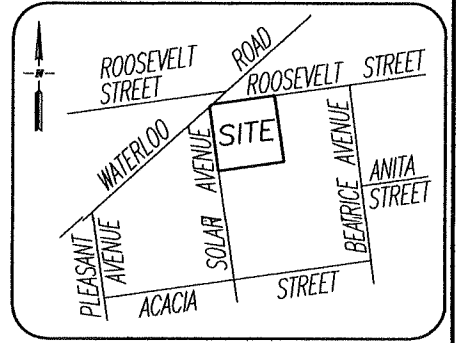


VICINITY MAP

NO SCALE

MONUMENTS FOUND AND SET:

- SET 3/4" REBAR 30" LONG WITH CAP STAMPED "PLS 7736"
- FD. 3/4" IRON ROD, NO TAG, NO REF., UNLESS OTHERWISE NOTED.
- ⊙ FD. 1/2" IRON PIPE PER (R1), NO TAG.
- ⊗ FD. RRS, NO REF.

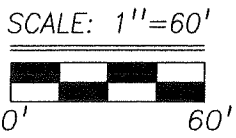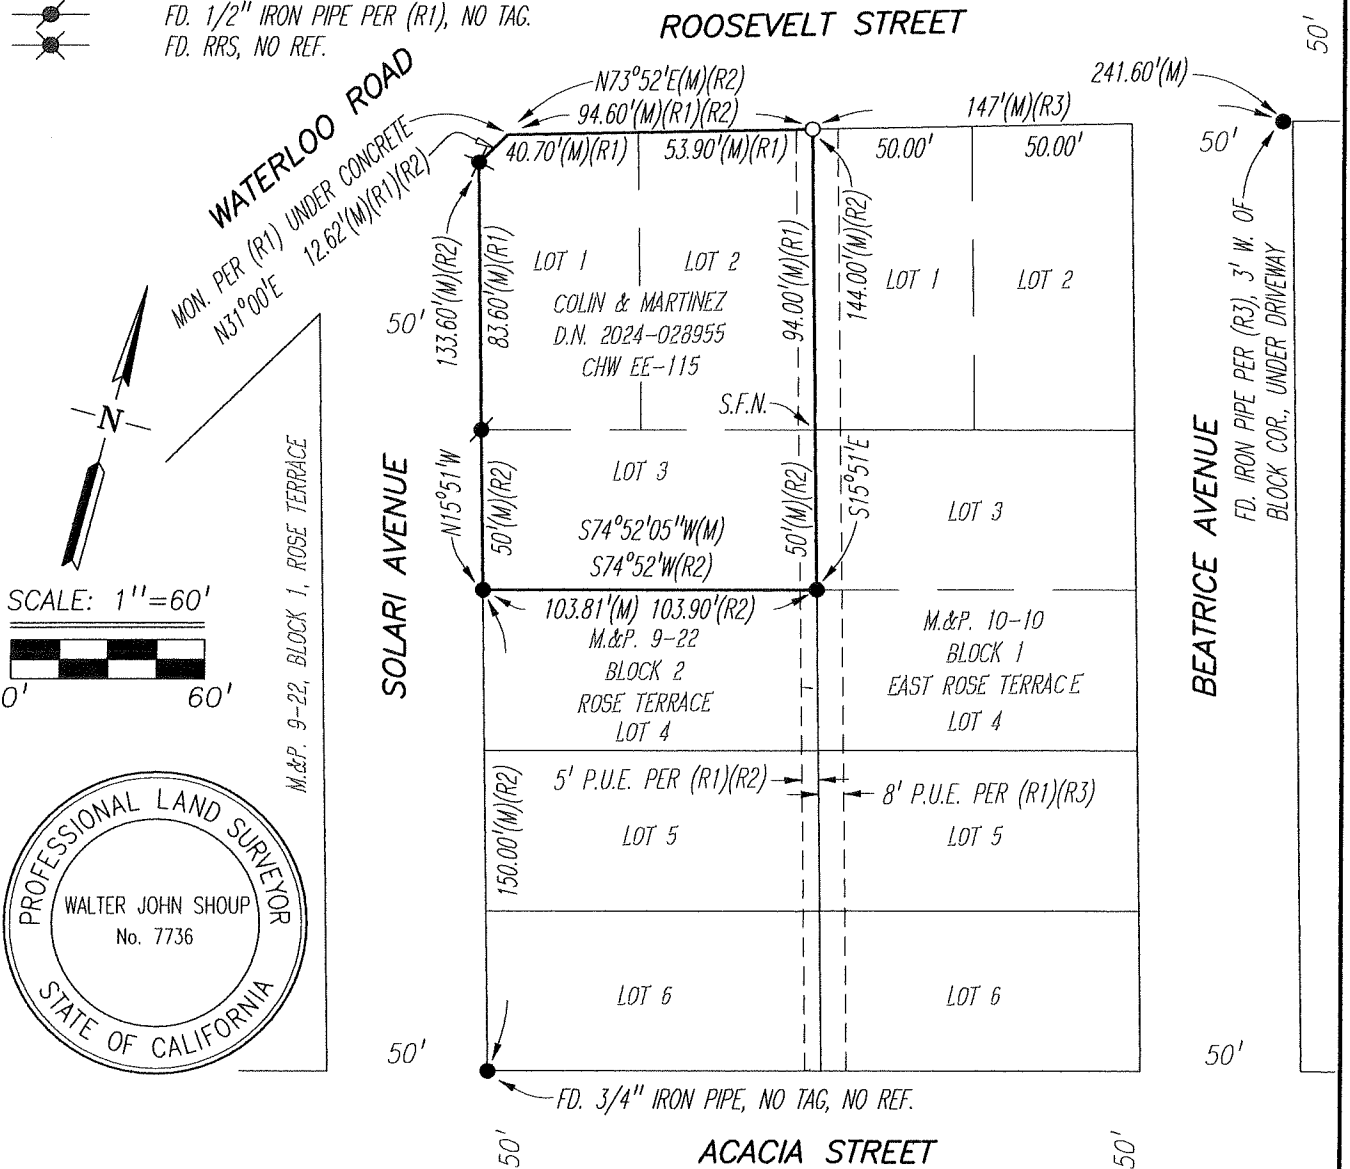

Scale: 1"=60'
 Job No.: 26-011

CORNER RECORD
EXHIBIT MAP

Date: 02/26/2025
 DWG: 26011CR.DWG