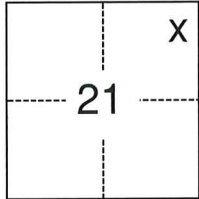


CORNER RECORD

Agency Index CR-26-119

Document Number _____

City of STOCKTON County of SAN JOAQUIN, CaliforniaBrief Legal Description 30 M&P 77, S.J.C.R.**CORNER TYPE****COORDINATES (Optional)**

- Government Corner Control
 Meander Property
 Rancho Other

N. _____ E. _____

Elevation _____

Units Metric U.S. Survey Foot

Horizontal Datum _____

Zone _____ Epoch Date _____

Vertical Datum _____

 Complies with Public Resources Code §§8801-8819 Complies with Public Resources Code §§8890-8902Date of Survey February 11, 2026T1N.,R6E.PLS Act Ref.: 8765(d) 8771 8773 Other:

Corner/
 Monument: Left as found Established Rebuilt Pre-Construction
 Found and tagged Reestablished Referenced Post-Construction

Narrative of corner identified and monument as found, set, reset, replaced, or removed:

 See sheet #2 for description(s):

FOUND CUT "+" AT PROJECTION OF PROPERTY LINES FROM THE NORTHWEST CORNERS OF LOTS 124, 125 & 126 PER 30 M&P 077. FOUND CUT "+" AT PROJECTION OF PROPERTY LINES FROM THE NORTHEAST CORNER OF LOT 131 PER 30 M&P 077.

SURVEYOR'S STATEMENT


This Corner Record was prepared by me or under my direction in conformance with

the Professional Land Surveyors' Act on February 12, 2026Signed *Ronald E. Monsour* (P.L.S.) or R.C.E. No. 8474**COUNTY SURVEYOR'S STATEMENT**This Corner Record was received March 5, 2026and examined and filed March 17, 2026Signed *James E. Hart* P.L.S. or R.C.E. No. 8657Title County Surveyor

County Surveyor's Comment _____




35691686

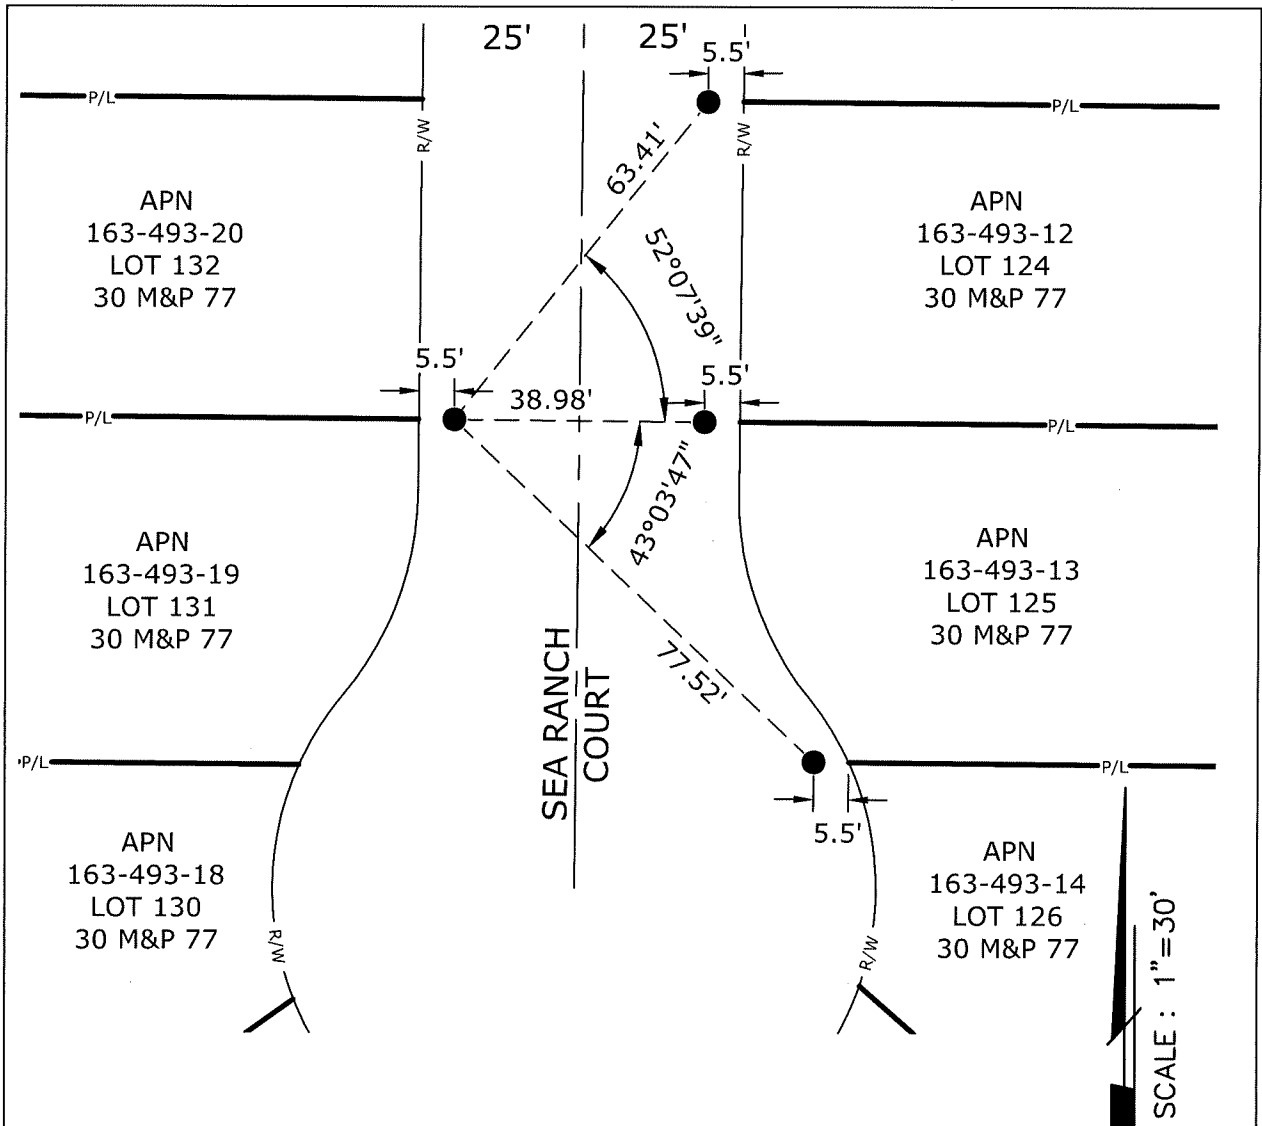

LEGEND:

- FOUND "+" ON SIDEWALK
- S.J.C.R. SAN JOAQUIN COUNTY RECORDS
- APN ASSESSOR'S PARCEL NUMBER
- M&P MAPS & PLATS

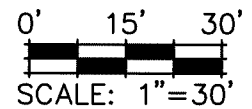

REFERENCE(S):

30 M&P 77, S.J.C.R.

NOTE: THE PURPOSE OF THIS CORNER RECORD IS TO PERPETUATE THE POSITION(S) OF EXISTING MONUMENT(S). NO REPRESENTATION IS MADE TO ANY RELATIVE POSITION(S) OF SAID MONUMENT(S). ALL RIGHT OF WAY, PROPERTY LINES, CENTERLINES AND OTHERS ARE FOR GRAPHICAL REPRESENTATION ONLY.

905 Sutter St. Suite 200, Folsom, CA 95630
 (916) 366-3040 Fax: (916) 366-3303
R. E. Y. ENGINEERS, Inc.
 Civil Engineers / Land Surveyors

**CORNER RECORD
EXHIBIT MAP**

SCALE: 1" = 30'
JOB NO: 35691686
DATE: 2/27/2026
DWG: 35691686.dwg