

CORNER RECORD

Agency Index CR-26-141

Document Number _____

City of STOCKTON

County of SAN JOAQUIN, California

Brief Legal Description BRICK AND TILE CIRCLE

CORNER TYPE

COORDINATES (Optional)



T.1N., R.6E.

- Government Corner Control
 Meander Property
 Rancho Other

N. _____ E. _____
 Elevation _____
 Units Metric U.S. Survey Foot
 Horizontal Datum _____
 Zone _____ Epoch Date _____
 Vertical Datum _____

Date of Survey 10-29-25

- Complies with Public Resources Code §§8801-8819
 Complies with Public Resources Code §§8890-8902

PLS Act Ref: 8765(d) 8771 8773 Other:

Corner/Monument: Left as found Established Rebuilt Pre-Construction
 Found and tagged Reestablished Referenced Post-Construction

Narrative of corner identified and monument as found, set, reset, replaced, or removed:
 See sheet #2 for description (s):

FOUND TWO (2) CHISELED "+" IN WALK, NO TAG PER (R1); SET FOUR (4) CONCRETE NAILS WITH BRASS TAG "LS 9857" AS WITNESS CORNERS, ALL AS SHOWN ON SHEET 2.

SURVEYOR'S STATEMENT

This Corner Record was prepared by me or under my direction in conformance with the Professional Land Surveyors' Act on MARCH 19, 2026

Signed Tanya Cissell P.L.S. or R.C.E. No. 9857



COUNTY SURVEYOR'S STATEMENT

This Corner Record was received March 20, 2026 and examined and filed March 20, 2026

Signed James E. Hart P.L.S. or R.C.E. No. 8657

Title County Surveyor



County Surveyor's Comment _____

LEGEND:

- ⊗ SET CONCRETE NAIL WITH BRASS TAG "LS 9857".
- FOUND MONUMENT AS NOTED.
- M&P- MAPS AND PLATS, S.J.C.R.
- S.J.C.R. SAN JOAQUIN COUNTY RECORDS
- (M) MEASURED DISTANCE. ALL DISTANCES ARE MEASURED UNLESS NOTED OTHERWISE.

NOTE:

THIS CORNER RECORD DOES NOT VERIFY THIS MONUMENT TO BE IN THE CORRECT POSITION.

94

REFERENCE:

(R1) 29-M&P-100, S.J.C.R.

∠ AND DISTANCE TABLE		
BS-@-FS	∠	FS DISTANCE
C-A-C	00°00'00"	130.39'(M)
C-A-B	00°44'29"	63.21'(M)
C-A-D	327°01'43"	82.92'(M)
C-A-E	249°53'56"	43.35'(M)
C-A-F	314°02'46"	57.71'(M)



SCALE: 1" = 20'


95

29-M&P-100

96

FOUND CHISELED "+" IN WALK,
NO TAG (R1)

BRICK AND TILE CIRCLE

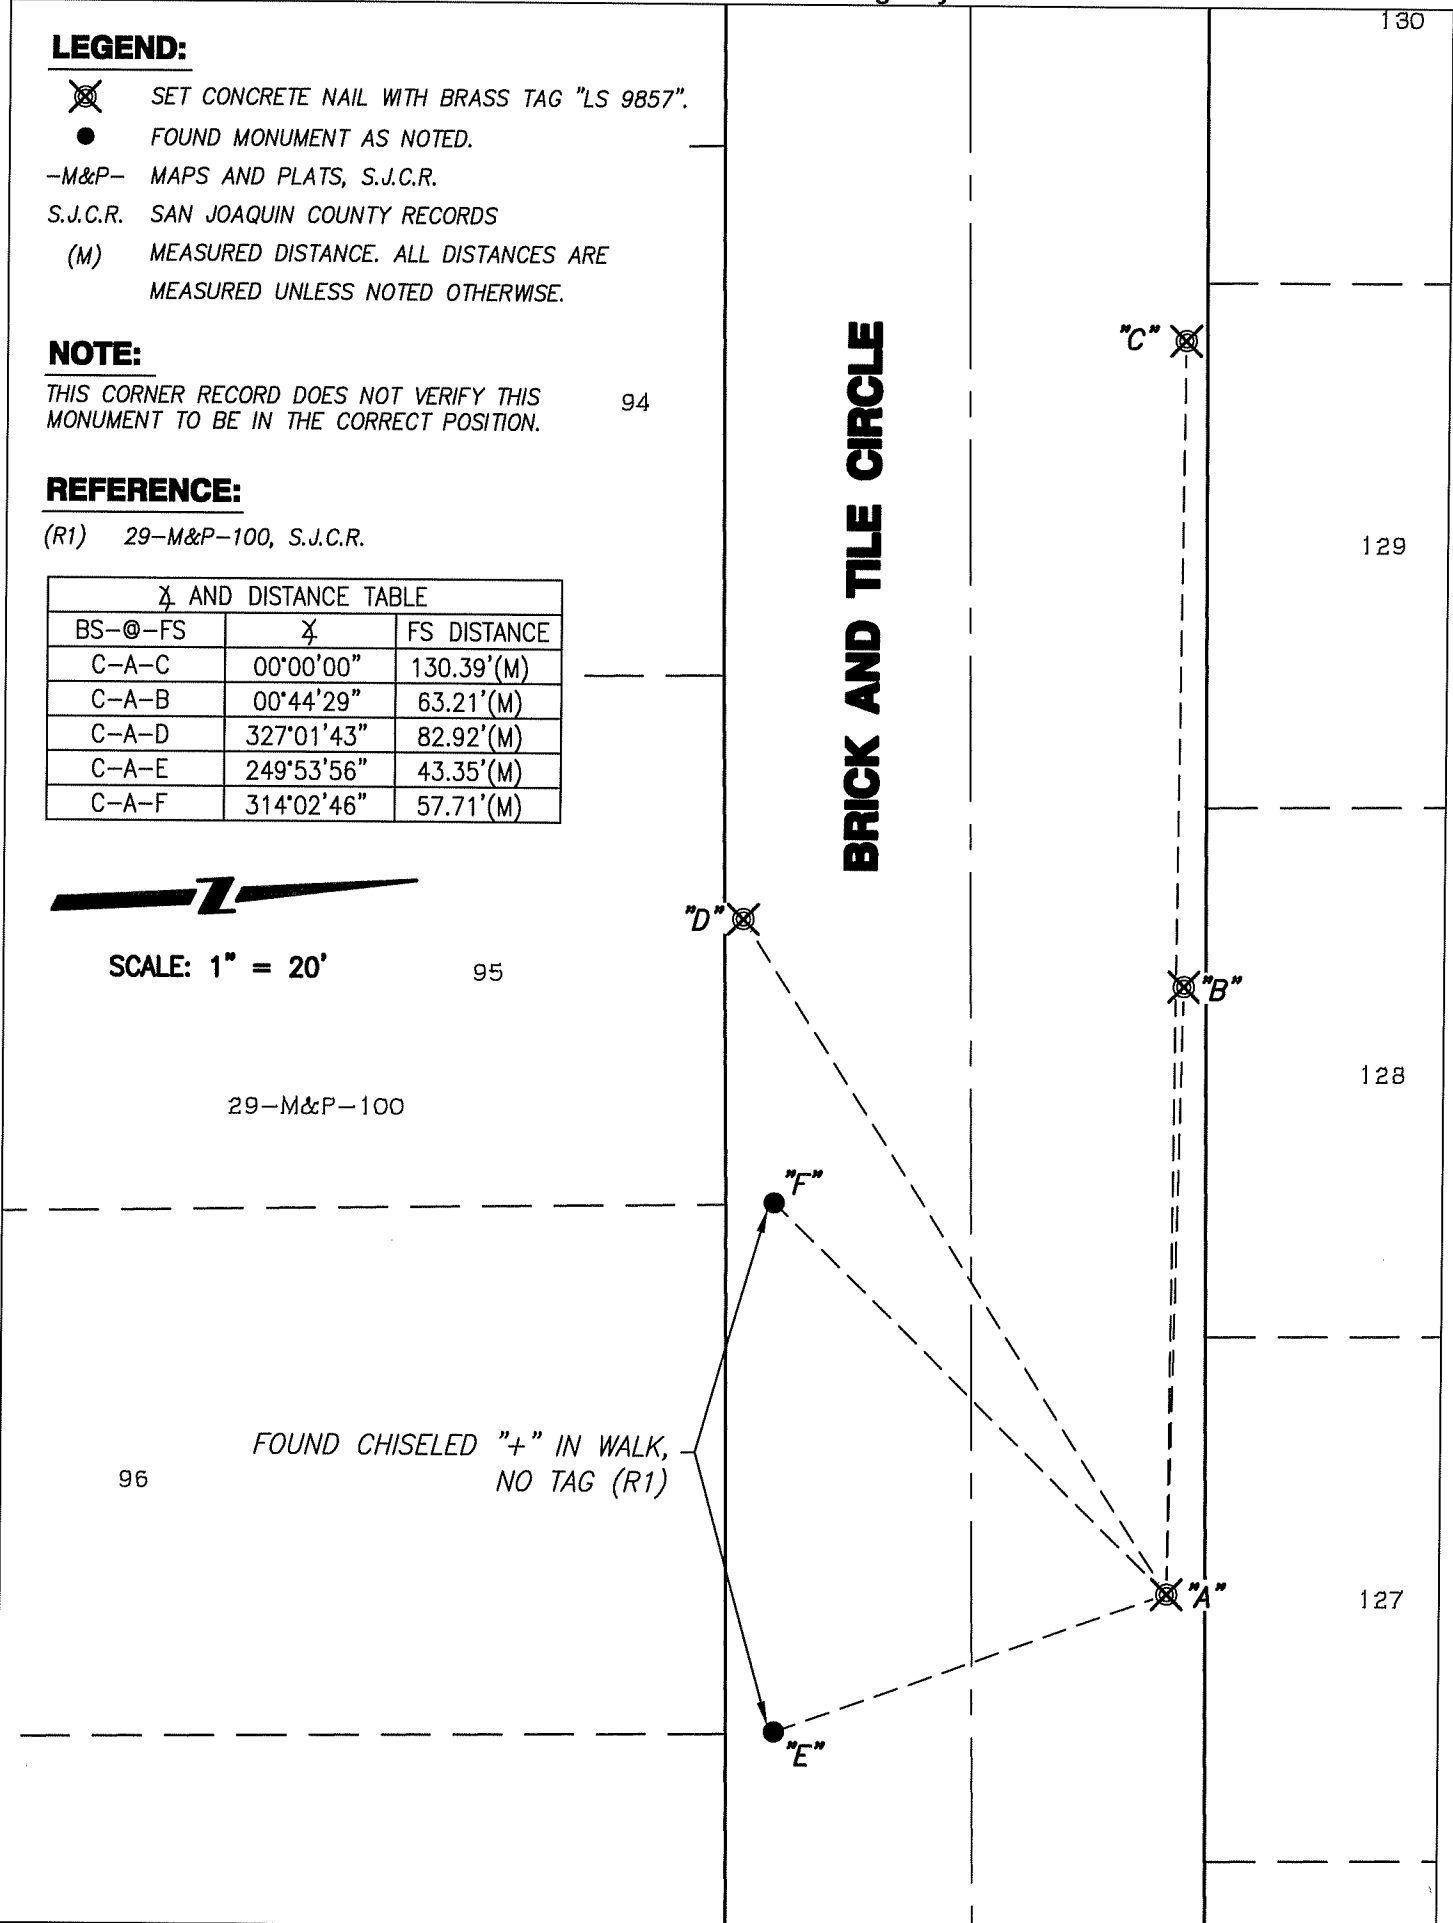

130

129

128

127