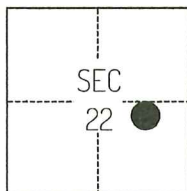


CORNER RECORD

Agency Index

CR-26-164

Document Number

City of STOCKTON County of SAN JOAQUIN, CaliforniaBrief Legal Description FOUND MONUMENTS ALONG THE WESTERLY RIGHT OF WAY OF SACRAMENTO STREET.**CORNER TYPE****COORDINATES (Optional)**

C.M. WEBER GRANT

- ☐ Government Corner ☐ Control
☐ Meander ☒ Property
☐ Rancho ☐ Other

Date of Survey June 4, 2024

N. _____ E. _____

Elevation _____

Units ☐ Metric ☒ U.S. Survey Foot

Horizontal Datum _____

Zone _____ Epoch Date _____

Vertical Datum _____

☐ Complies with Public Resources Code §§8801-8819☐ Complies with Public Resources Code §§8890-8902

PLS Act Ref.:

☐ 8765(d)☒ 8771☐ 8773☐ Other:Corner/
Monument:☒ Left as found☐ Established☐ Rebuilt☒ Pre-Construction☐ Found and tagged☐ Reestablished☒ Referenced☐ Post-Construction

Narrative of corner identified and monument as found, set, reset, replaced, or removed:

☒ See sheet #2 for description(s):

THE FOUND MONUMENT(S) SHOWN ON THIS CORNER RECORD WERE FOUND AT THE LOCATION OF THE CORNER(S) ON CORNER RECORDS 25-178 AND 25-179, SAN JOAQUIN COUNTY SURVEYOR'S RECORDS (OR WERE FOUND AS WITNESSES TO THOSE CORNERS). I DID NOT VERIFY THE IDENTITY AND VALIDITY OF THE MONUMENT FOUND AS ACTUALLY MARKING THE PROPERTY CORNER.

SURVEYOR'S STATEMENT

This Corner Record was prepared by me or under my direction in conformance with

the Professional Land Surveyors' Act on August 5, 2025

Signed

P.L.S. or R.C.E. No.

8489**COUNTY SURVEYOR'S STATEMENT**

This Corner Record was received

MARCH 26, 2026

and examined and filed

MAY 15, 2026

Signed

P.L.S. or R.C.E. No.


9728

Title

County Surveyor

County Surveyor's Comment



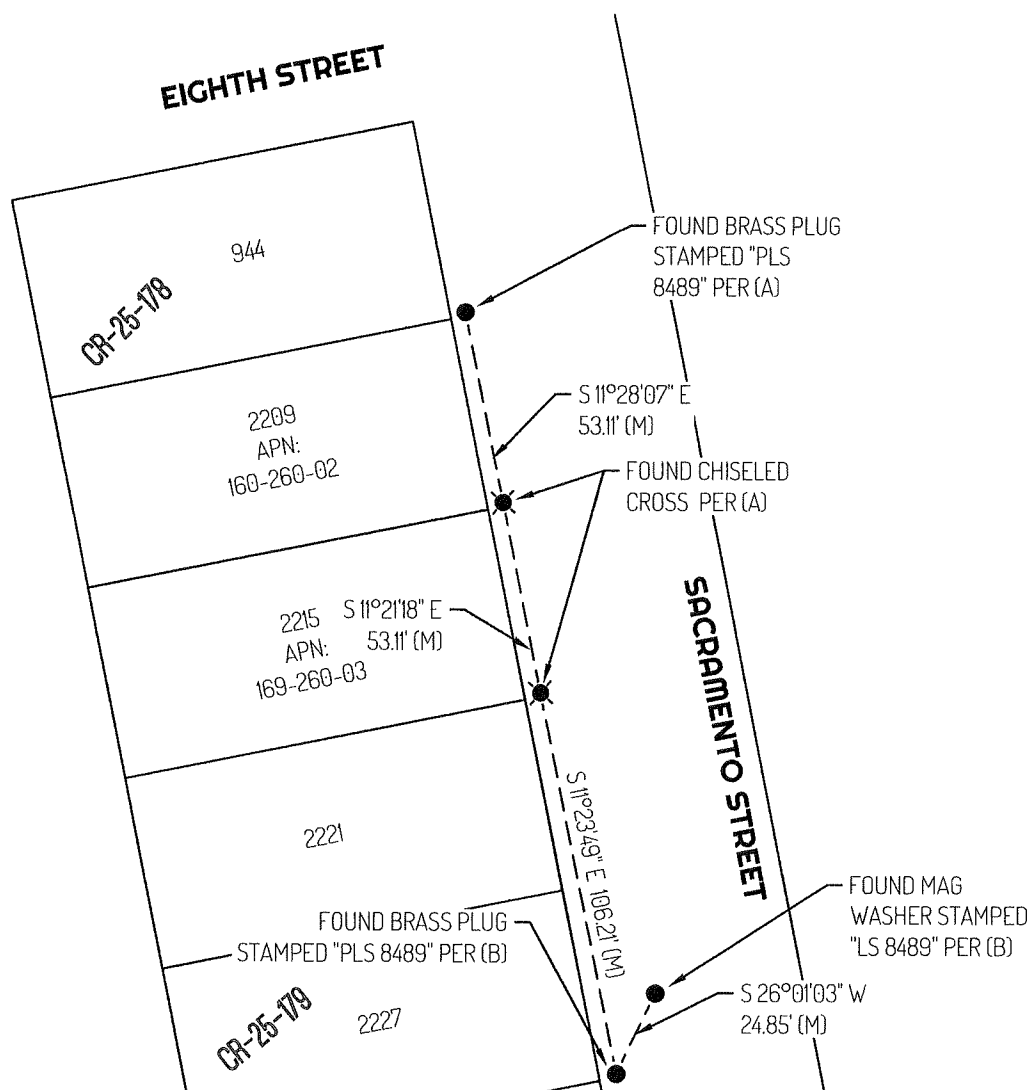

LEGEND

- FOUND MONUMENT AS NOTED PER (A)
- ⊕ FOUND CHISELED CROSS PER (A)
- 2221 REFERENCE STREET ADDRESS
- CR CORNER RECORD, SAN JOAQUIN COUNTY SURVEYOR'S RECORDS
- (M) MEASURED
- APN TAX ASSESSOR PARCEL NUMBER
- TIE LINE
- LOT LINE

REFERENCES

- (A) CORNER RECORD 25-178, SAN JOAQUIN COUNTY SURVEYOR'S RECORDS
- (B) CORNER RECORD 25-179, SAN JOAQUIN COUNTY SURVEYOR'S RECORDS

