


CORNER RECORD

Agency Index CR-26-167
Document Number _____

City of STOCKTON County of SAN JOAQUIN, California
Brief Legal Description FOUND MONUMENTS ALONG THE WESTERLY RIGHT OF WAY OF SACRAMENTO STREET.

CORNER TYPE

COORDINATES (Optional)

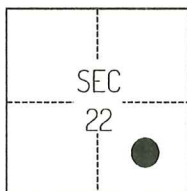

C.M. WEBER GRANT

- ☐ Government Corner ☐ Control
☐ Meander ☒ Property
☐ Rancho ☐ Other

Date of Survey June 4, 2024

N. _____ E. _____

Elevation _____

Units ☐ Metric ☒ U.S. Survey Foot

Horizontal Datum _____

Zone _____ Epoch Date _____

Vertical Datum _____

☐ Complies with Public Resources Code §§8801-8819

☐ Complies with Public Resources Code §§8890-8902

PLS Act Ref.: ☐ 8765(d) ☒ 8771 ☐ 8773 ☐ Other:

Corner/
Monument: ☒ Left as found ☐ Established ☐ Rebuilt ☒ Pre-Construction
☐ Found and tagged ☐ Reestablished ☒ Referenced ☐ Post-Construction

Narrative of corner identified and monument as found, set, reset, replaced, or removed:

☒ See sheet #2 for description(s):

THE FOUND MONUMENT(S) SHOWN ON THIS CORNER RECORD WERE FOUND AT THE LOCATION OF THE CORNER(S) ON CORNER RECORDS 25-180 AND 25-181, SAN JOAQUIN COUNTY SURVEYOR'S RECORDS (OR WERE FOUND AS WITNESSES TO THOSE CORNERS). I DID NOT VERIFY THE IDENTITY AND VALIDITY OF THE MONUMENT FOUND AS ACTUALLY MARKING THE PROPERTY CORNER.

SURVEYOR'S STATEMENT

This Corner Record was prepared by me or under my direction in conformance with

the Professional Land Surveyors' Act on June 4, 2024.

Signed [Signature] P.L.S. or R.C.E. No. 8489



COUNTY SURVEYOR'S STATEMENT


This Corner Record was received


and examined and filed

Signed [Signature] P.L.S. or R.C.E. No. 9728

Title County Surveyor

County Surveyor's Comment

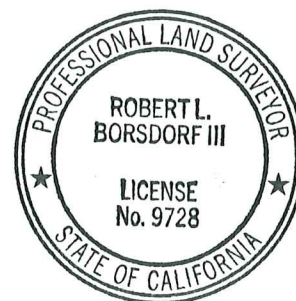

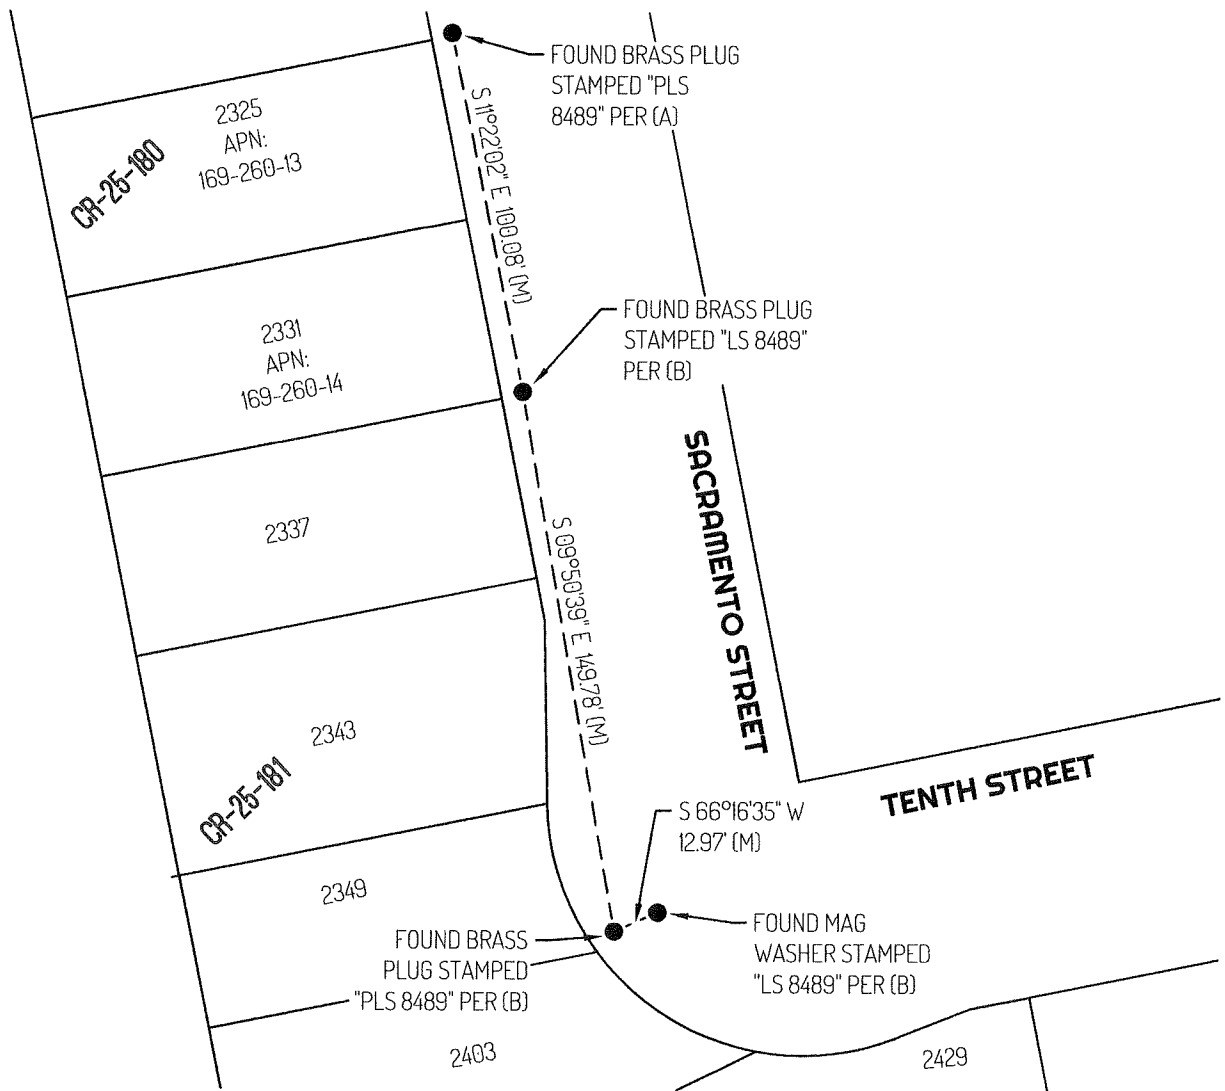

LEGEND

●	FOUND MONUMENT AS NOTED PER (A)
⊕	FOUND CHISELED CROSS PER (A)
2349	REFERENCE STREET ADDRESS
CR	CORNER RECORD, SAN JOAQUIN COUNTY SURVEYOR'S RECORDS
(M)	MEASURED
APN	TAX ASSESSOR'S PARCEL NUMBER
---	TIE LINE
—	LOT LINE

REFERENCES

- (A) CORNER RECORD 25-180, SAN JOAQUIN COUNTY SURVEYOR'S RECORDS
 (B) CORNER RECORD 25-181, SAN JOAQUIN COUNTY SURVEYOR'S RECORDS

