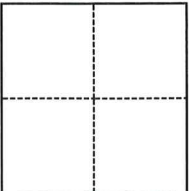


CORNER RECORD

Agency Index CR-26-180
Document Number _____

City of _____ County of San Joaquin, California
Brief Legal Description Monuments found along Davis Road

CORNER TYPE		COORDINATES (Optional)	
	☐ Government Corner	☐ Control	N. _____ E. _____
	☐ Meander	☒ Property	Elevation _____
	☐ Rancho	☐ Other	Units ☐ Metric ☐ U.S. Survey Foot
	Date of Survey <u>May 7, 2025</u>		Horizontal Datum _____
		Zone _____ Epoch Date _____	Vertical Datum _____
		☐ Complies with Public Resources Code §§8801-8819	
		☐ Complies with Public Resources Code §§8890-8902	

Section 4, T.2N., R.6E, M.D.M.

PLS Act Ref.:	☐ 8765(d)	☒ 8771	☐ 8773	☐ Other:
Corner/ Monument:	☒ Left as found	☐ Established	☐ Rebuilt	☒ Pre-Construction
	☐ Found and tagged	☐ Reestablished	☒ Referenced	☐ Post-Construction

Narrative of corner identified and monument as found, set, reset, replaced, or removed:

☒ See sheet #2 for description(s):


SURVEYOR'S STATEMENT

This Corner Record was prepared by me or under my direction in conformance with

the Professional Land Surveyors' Act on

APRIL 14, 2026

Signed

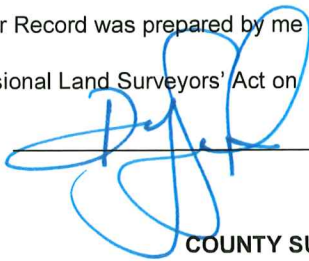

P.L.S. or R.C.E. No.

PLS 8366



COUNTY SURVEYOR'S STATEMENT


This Corner Record was received

April 13, 2026

and examined and filed

MAY 15, 2026

Signed

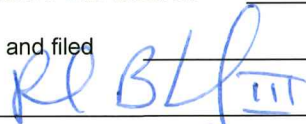

P.L.S. or R.C.E. No.

9728

Title

County Surveyor

County Surveyor's Comment



