

CORNER RECORD

Agency Index

CR-26-1.84

Document Number

UNINCORPORATED AREA

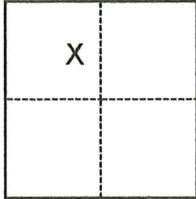
County of

SAN JOAQUIN

, California

Brief Legal Description

NORTH LINE OF R.S. 17-69, S.J.C.R.

CORNER TYPE**COORDINATES (Optional)**

- ☐ Government Corner ☐ Control
☐ Meander ☒ Property
☐ Rancho ☐ Other

Date of Survey January 29, 2026

N. _____ E. _____

Elevation _____

Units ☐ Metric ☐ U.S. Survey Foot

Horizontal Datum _____

Zone _____ Epoch Date _____

Vertical Datum _____

☐ Complies with Public Resources Code §§8801-8819☐ Complies with Public Resources Code §§8890-8902SEC. 20, T3N, R7E
M.D.B.&M.

PLS Act Ref.:

☒ 8765(d)☐ 8771☐ 8773☐ Other:Corner/
Monument:☒ Left as found☐ Established☐ Rebuilt☐ Pre-Construction☐ Found and tagged☐ Reestablished☐ Referenced☐ Post-Construction

Narrative of corner identified and monument as found, set, reset, replaced, or removed:

☒ See sheet #2 for description(s):

SEE PAGE 2 OF 2 FOR MONUMENTS FOUND.

SURVEYOR'S STATEMENT

This Corner Record was prepared by me or under my direction in conformance with

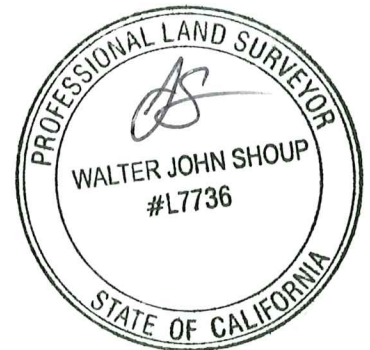
the Professional Land Surveyors' Act on

04/21/2026

Signed

Walter John Shoup

P.L.S. or R.C.E. No.

L-7736**COUNTY SURVEYOR'S STATEMENT**

This Corner Record was received

and examined and filed

April 22, 2026MAY 15, 2026

Signed

Robert L. Borsdorf III

P.L.S. or R.C.E. No.

9728

Title

County Surveyor

County Surveyor's Comment



