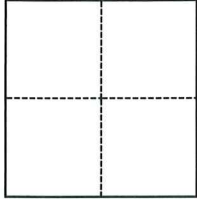


CORNER RECORD

Agency Index

CR-26-185

Document Number

City of LODI County of San Joaquin, CaliforniaBrief Legal Description LOT 9 IN BLOCK 2 OF M.&P. 3-53**CORNER TYPE**

- ☐ Government Corner ☐ Control
☐ Meander ☒ Property
☐ Rancho ☐ Other

Date of Survey September 4, 2025**COORDINATES (Optional)**

N. _____ E. _____

Elevation _____

Units ☐ Metric ☐ U.S. Survey Foot

Horizontal Datum _____

Zone _____ Epoch Date _____

Vertical Datum _____

☐ Complies with Public Resources Code §§8801-8819☐ Complies with Public Resources Code §§8890-8902

PLS Act Ref.:

☐ 8765(d)☐ 8771☐ 8773☐ Other:Corner/
Monument:☐ Left as found☐ Established☐ Rebuilt☐ Pre-Construction☐ Found and tagged☒ Reestablished☐ Referenced☒ Post-Construction

Narrative of corner identified and monument as found, set, reset, replaced, or removed:

☒ See sheet #2 for description(s):**SURVEYOR'S STATEMENT**

This Corner Record was prepared by me or under my direction in conformance with

the Professional Land Surveyors' Act on

April 1, 2026

Signed

(P.L.S.) or R.C.E. No.

7269**COUNTY SURVEYOR'S STATEMENT**

This Corner Record was received

and examined and filed

April 20, 2026May 15, 2026

Signed

P.L.S. or R.C.E. No.


9728

Title

County Surveyor

County Surveyor's Comment



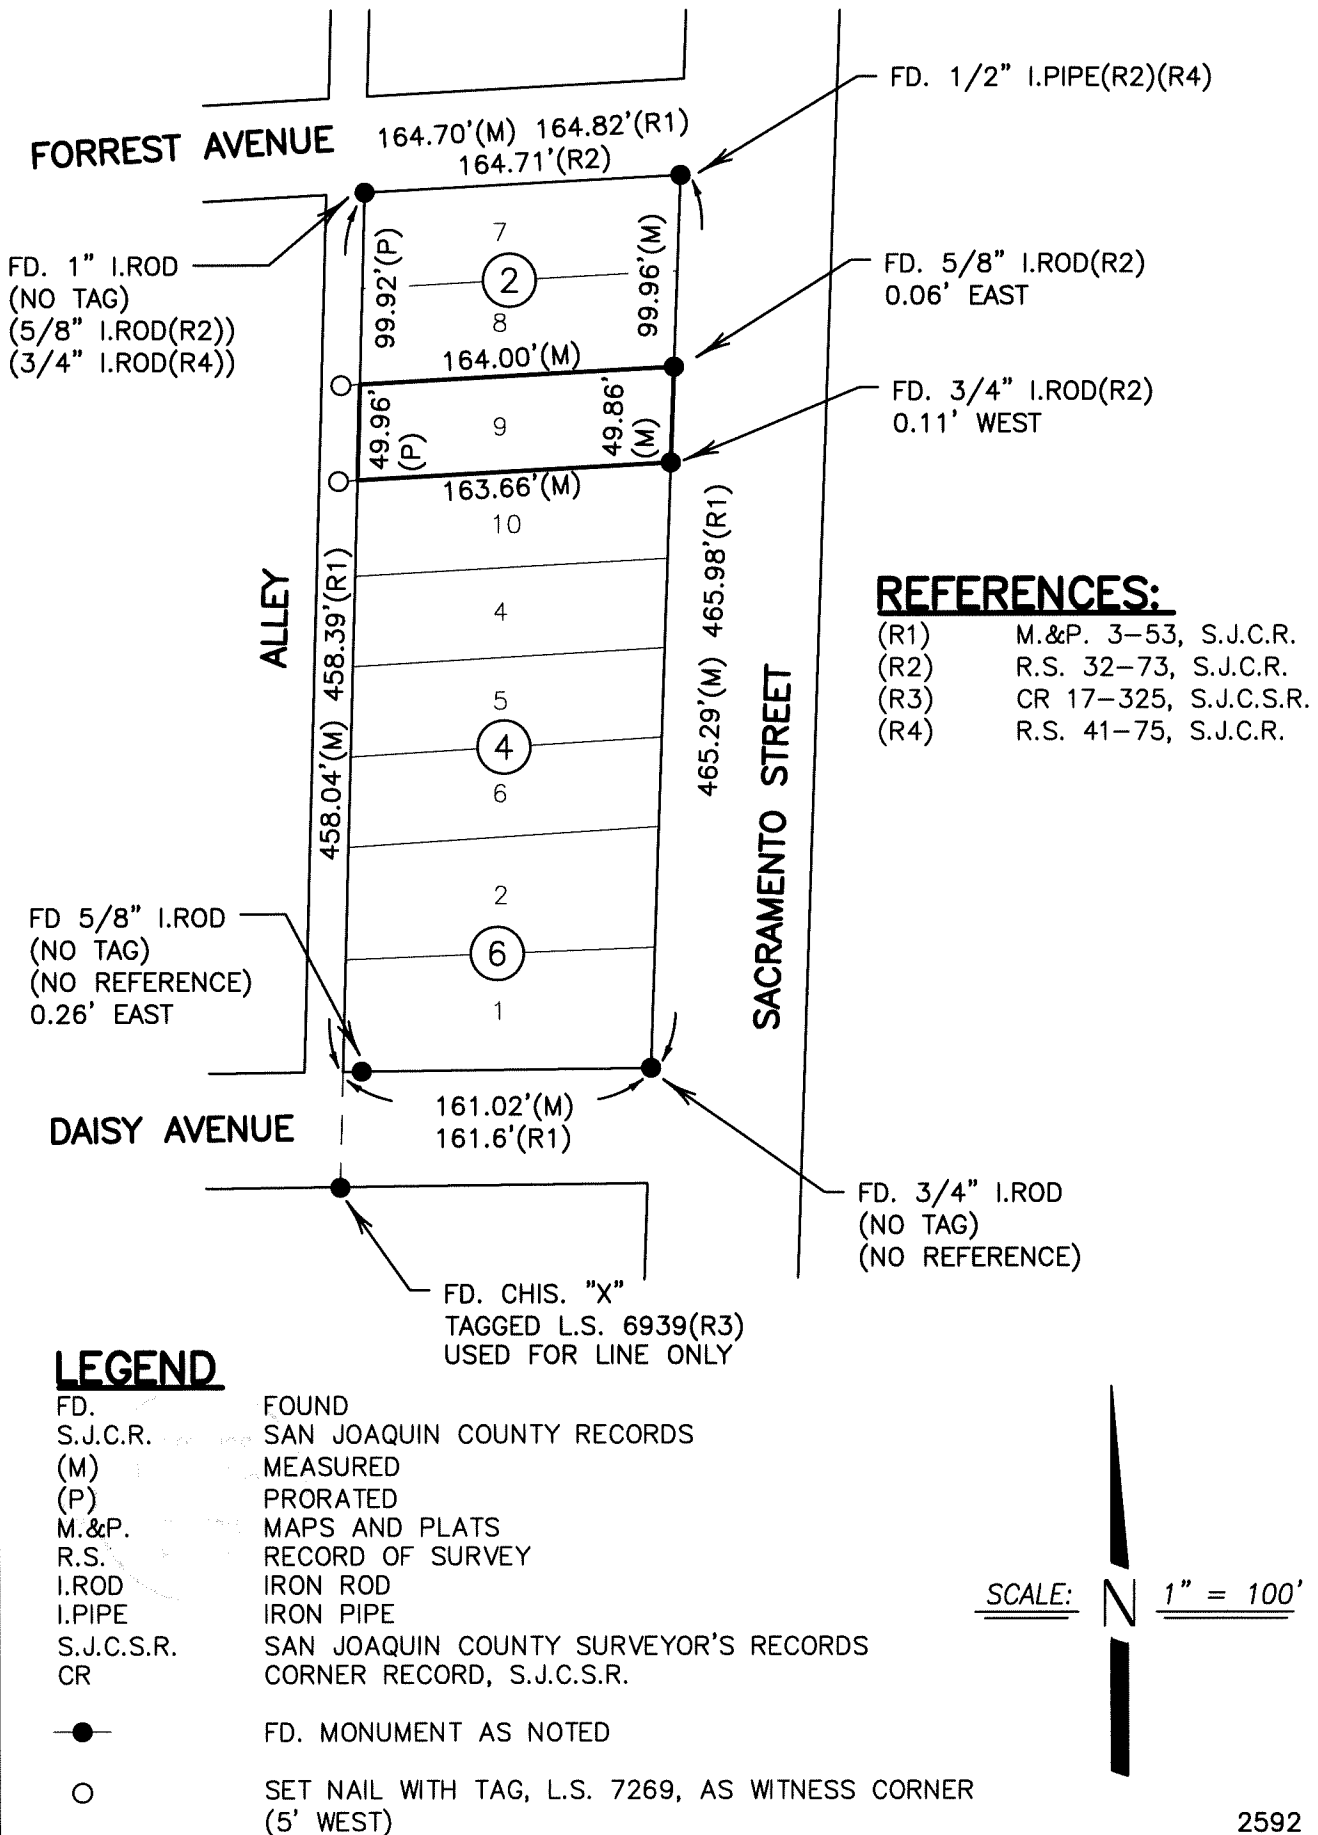

2592