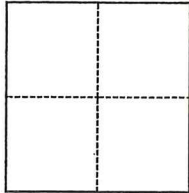


CORNER RECORD

Agency Index

CR-26-186

Document Number

City of Unincorporated County of San Joaquin, CaliforniaBrief Legal Description Parcel A--22 P.M. 118**CORNER TYPE****COORDINATES (Optional)**

- ☐ Government Corner ☐ Control
☐ Meander ☒ Property
☐ Rancho ☐ Other

Date of Survey January 13, 2026N. E. Elevation Units ☐ Metric ☒ U.S. Survey FootHorizontal Datum Zone Epoch Date Vertical Datum ☐ Complies with Public Resources Code §§8801-8819☐ Complies with Public Resources Code §§8890-8902

PLS Act Ref.:

☒ 8765(d)☐ 8771☐ 8773☐ Other:Corner/
Monument:☒ Left as found☒ Established☐ Rebuilt☐ Pre-Construction☐ Found and tagged☐ Reestablished☐ Referenced☐ Post-Construction

Narrative of corner identified and monument as found, set, reset, replaced, or removed:

☒ See sheet #2 for description(s):

Found monuments from 22 P.M. 118

SURVEYOR'S STATEMENT

This Corner Record was prepared by me or under my direction in conformance with

the Professional Land Surveyors' Act on February 3, 2026 & 3/26/26Signed Michael T. Turnure (P.L.S.) or R.G.E. No. 7454**COUNTY SURVEYOR'S STATEMENT**


This Corner Record was received

and examined and filed

Signed Robert L. Borsdorf III P.L.S. or R.G.E. No. 9728Title County Surveyor

County Surveyor's Comment



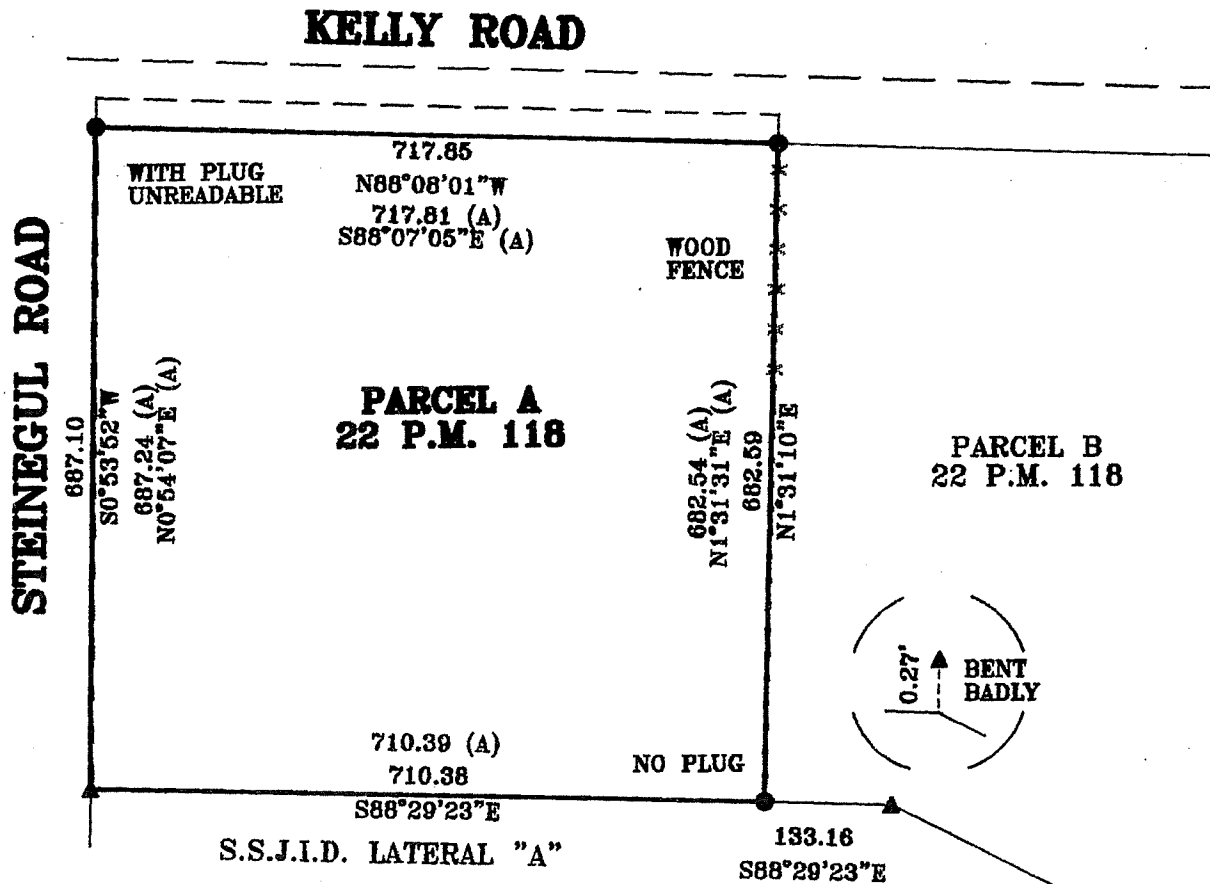

25-46