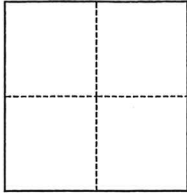


CORNER RECORD

Agency Index

CR-26-189

Document Number

City of Unincorporated County of San Joaquin, CaliforniaBrief Legal Description Parcel 2--20 P.M. 188**CORNER TYPE****COORDINATES (Optional)**

- ☐ Government Corner ☐ Control
☐ Meander ☒ Property
☐ Rancho ☐ Other

Date of Survey February 4, 2026

N. _____ E. _____

Elevation _____

Units ☐ Metric ☒ U.S. Survey Foot

Horizontal Datum _____

Zone _____ Epoch Date _____

Vertical Datum _____

☐ Complies with Public Resources Code §§8801-8819☐ Complies with Public Resources Code §§8890-8902

PLS Act Ref.:

☒ 8765(d)☐ 8771☐ 8773☐ Other:Corner/
Monument:☒ Left as found☒ Established☐ Rebuilt☐ Pre-Construction☐ Found and tagged☐ Reestablished☐ Referenced☐ Post-Construction


Narrative of corner identified and monument as found, set, reset, replaced, or removed:

☒ See sheet #2 for description(s):

Found monuments from 20 P.M. 188. Used to set northeast and northwest corners.

SURVEYOR'S STATEMENT

This Corner Record was prepared by me or under my direction in conformance with

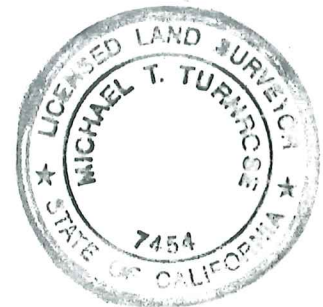the Professional Land Surveyors' Act on February 26, 2026 & 4/21/26Signed Michael T. Turnrose (P.L.S.) or R.C.E. No. 7454**COUNTY SURVEYOR'S STATEMENT**

This Corner Record was received

and examined and filed

Signed ROBERT L. BORS DORF III P.L.S. or R.C.E. No. 9728Title County Surveyor

County Surveyor's Comment



