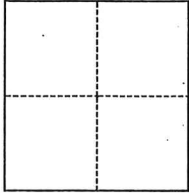


CORNER RECORD

Agency Index

CR-26-190

Document Number

City of Tracy County of San Joaquin, CaliforniaBrief Legal Description Lot 91, 26 M&P 80**CORNER TYPE****COORDINATES (Optional)**

- ☐ Government Corner ☐ Control
☐ Meander ☒ Property
☐ Rancho ☐ Other

Date of Survey February 27, 2026

N. _____ E. _____

Elevation _____

Units ☐ Metric ☒ U.S. Survey Foot

Horizontal Datum _____

Zone _____ Epoch Date _____

Vertical Datum _____

☐ Complies with Public Resources Code §§8801-8819☐ Complies with Public Resources Code §§8890-8902

PLS Act Ref.:

☒ 8765(d)☐ 8771☐ 8773☐ Other:Corner/
Monument:☒ Left as found☒ Established☐ Rebuilt☐ Pre-Construction☐ Found and tagged☐ Reestablished☐ Referenced☐ Post-Construction

Narrative of corner identified and monument as found, set, reset, replaced, or removed:

☒ See sheet #2 for description(s):

Found monuments from 26 M&P 80

SURVEYOR'S STATEMENT

This Corner Record was prepared by me or under my direction in conformance with

the Professional Land Surveyors' Act on March 3, 2026 & 4/21/26Signed Michael T. Turnore (P.L.S.) or R.C.E. No. 7454**COUNTY SURVEYOR'S STATEMENT**

This Corner Record was received


and examined and filed

Signed Robert L. Borsdorf III MAY 5, 2026 MAY 15, 2026 P.L.S. or R.C.E. No. 9728Title County Surveyor

County Surveyor's Comment



26-05

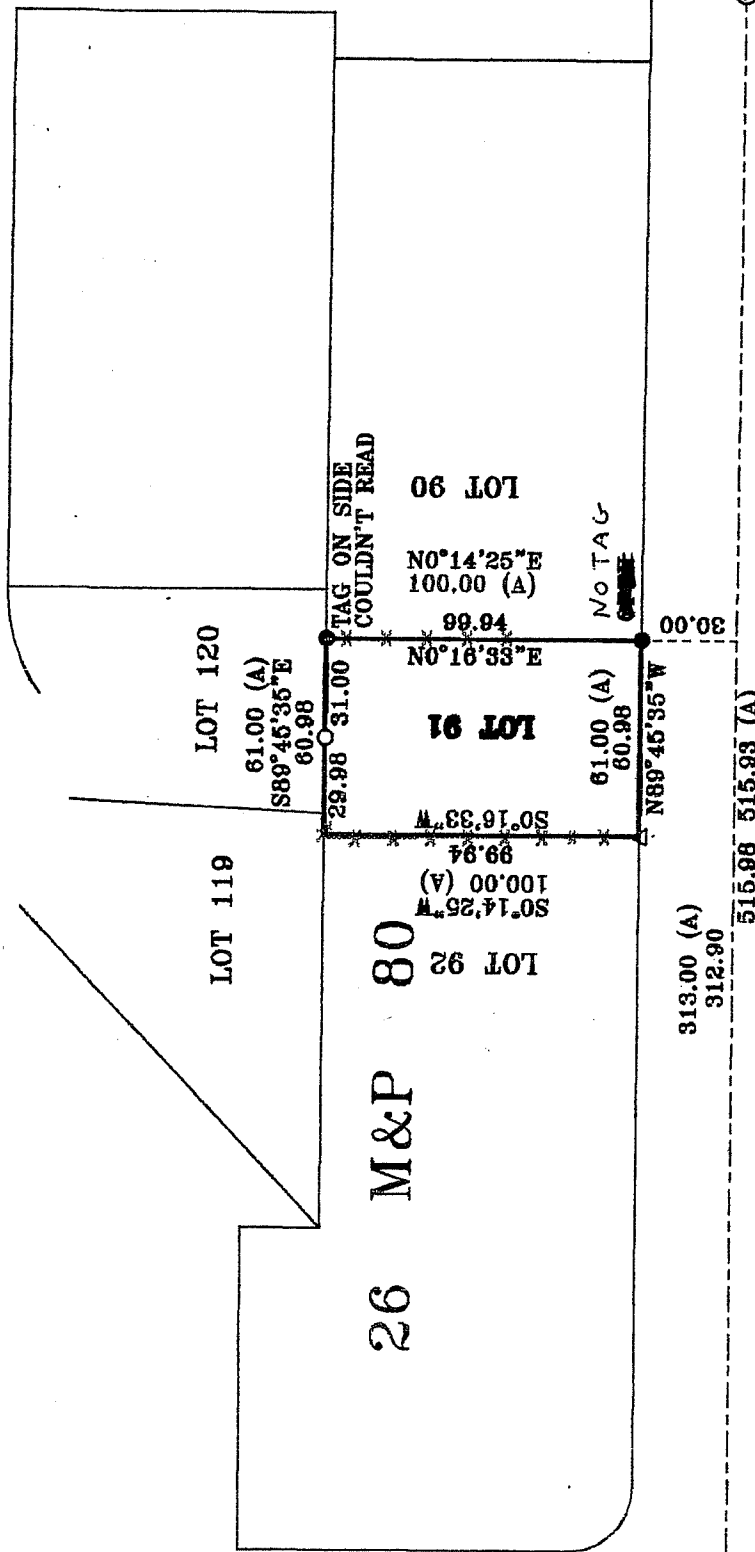**BLOSSOMWOOD
LANE****LEGEND:**

- ⊙ INDICATES FOUND 3" BRASS DISK STAMPED
L.S. 4876 ACCEPTED AS PER (A)
- INDICATES FOUND 1/2" IRON PIPE AS NOTED
AS PER (A)
- INDICATES SET 3/4" X 24" IRON PIPE WITH
PLASTIC PLUG STAMPED "TURNROSE L.S. 7454"
- △ INDICATES SET PK NAIL AND WASHER STAMPED
"TURNROSE L.S. 7454" ON TOP OF FENCE
- (A) DATA AS PER 26 M&P 80 OR CALCULATED THEREFROM
- M&P MAPS AND PLATS, SAN JOAQUIN COUNTY RECORDS
- *** INDICATES FENCE