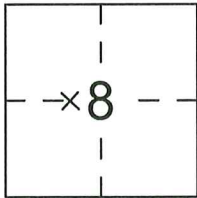


CORNER RECORD

Agency Index

CR-26-230

Document Number

City of _____ County of SAN JOAQUIN, CaliforniaBrief Legal Description NORTH CORNER BETWEEN LOT 5 AND LOT 6 OF TRACT NO.433, "IDLE HOUR FARM" FILED FOR RECORD IN VOLUME 14 OF MAPS AND PLATS AT PAGE 84, RECORDS OF SAN JOAQUIN COUNTY**CORNER TYPE****COORDINATES (Optional)**

- ☐ Government Corner ☐ Control
☐ Meander ☒ Property
☐ Rancho ☐ Other

Date of Survey 3-24-2026

N. _____ E. _____

Elevation. _____

Units ☐ Metric ☒ U.S. Survey Foot

Horizontal Datum _____

Zone _____ Epoch Date _____

Vertical Datum _____

☐ Complies with Public Resources Code §§8801-8819☐ Complies with Public Resources Code §§8890-8902

SECTION 8, TOWNSHIP 2 SOUTH, RANGE 7 EAST, M.D.B. & M.

PLS Act Ref.: ☐ 8765(d) ☒ 8771 ☐ 8773 ☐ Other:Corner/ ☒ Left as found ☐ Established ☐ Rebuilt ☒ Pre-ConstructionMonument: ☐ Found and tagged ☐ Reestablished ☐ Referenced ☐ Post-Construction

Narrative of corner identified and monument as found, set, reset, replaced, or removed:

☒ See sheet #2 for description(s):


FOUND 1" IRON PIPE, NO TAG AT THE NORTH CORNER BETWEEN LOT 5 AND LOT 6 OF TRACT NO. 433, "IDLE HOUR FARM" FILED FOR RECORD IN VOLUME 14 OF MAPS AND PLATS AT PAGE 84, RECORDS OF SAN JOAQUIN COUNTY

SURVEYOR'S STATEMENT

This Corner Record was prepared by me or under my direction in conformance with

the Professional Land Surveyor's Act on JUNE 18, 2026Signed Randell Scott West P.L.S. or R.C.E. No. 8663**COUNTY SURVEYOR'S STATEMENT**This Corner Record was received JUNE 25, 2026and examined and filed JULY 8, 2026Signed Robert L. Borsdorf III P.L.S. or R.C.E. No. 9728Title County Surveyor

County Surveyor's Comment

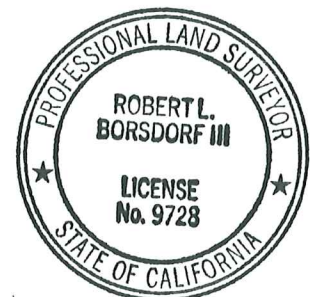

LEGEND:

- ⊙ INDICATES FOUND 1" IRON PIPE, NO TAG
- ⊗ INDICATES SET CUT CROSS IN TOP OF CURB
- INDICATES SET MAG NAIL AND SHINNER

M&P MAPS AND PLATS

S.J.C.R. SAN JOAQUIN COUNTY RECORDS

