

CORNER RECORD

Agency Index

CR-26-236

Document Number

City of _____ County of SAN JOAQUIN, CaliforniaBrief Legal Description A PORTION OF CRAIG ROAD AS SHOWN ON MAP OF AMANDA J. WILLIAMS TRACT, FILED FOR RECORD MAY 20, 1919 IN BOOK 9 OF MAPS AND PLATS AT PAGE 56, SAN JOAQUIN COUNTY RECORDS.

T2S, R9E, MDBM

CORNER TYPE

COORDINATES (Optional)



- | | |
|--|---|
| ☐ Government Corner | ☐ Control |
| ☐ Meander | ☐ Property |
| ☐ Rancho | ☒ Other |

N. _____ E. _____

Elevation _____

Units ☐ Metric ☒ U.S. Survey Foot

Horizontal Datum _____

Zone _____ Epoch Date _____

Vertical Datum _____

☐ Complies with Public Resources Code §§8801-8819☐ Complies with Public Resources Code §§8890-8902

PLS Act Ref.:

☒ 8765(d)☐ 8771☐ 8773☐ Other:Corner/
Monument:☒ Left as found☐ Established☐ Rebuilt☐ Pre-Construction☐ Found and tagged☒ Reestablished☒ Referenced☐ Post-Construction

Narrative of corner identified and monument as found, set, reset, replaced, or removed:

☒ See sheet #2 for description(s): **CORNERS RESET TO IDENTIFY CRAIG ROAD AT TERMINATION.**

SURVEYOR'S STATEMENT

This Corner Record was prepared by me or under my direction in conformance with

the Professional Land Surveyors' Act on JUNE 19, 2026

Signed

Robert Perez

(P.L.S.) or R.C.E. No.

9553

COUNTY SURVEYOR'S STATEMENT

This Corner Record was received

July 9, 2026

and examined and filed

July 15, 2026

Signed

Robert L. Borsdorf III

(P.L.S.) or R.C.E. No.


9728Title SAN JOAQUIN COUNTY SURVEYOR

County Surveyor's Comment




LEGEND

- (C) CALCULATED
 (M) MEASURED
 (R) BOOK 9 OF MAPS AND PLATS, PAGE 56, SJCR
 SJCR SAN JOAQUIN COUNTY RECORDS
 PM PARCEL MAP
 RS RECORD OF SURVEY
 MP MAPS AND PLATS
 ○ SNF SEARCHED NOTHING FOUND
 ● FOUND MONUMENT, AS NOTED
 ⊙ FOUND PVC CASING/WELL CAP
 ⊙ SET MONUMENT, AS NOTED

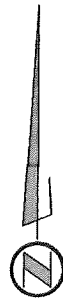

— — — — — CENTERLINE
 — — — — — PROPERTY LINE
 — — — — — RIGHT-OF-WAY

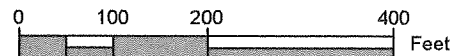

SCALE 1" = 200'

