

CORNER RECORD

Agency Index

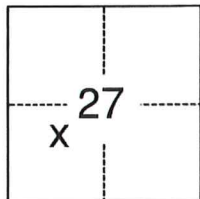
CR-26-246

Document Number

City of STOCKTONCounty of SAN JOAQUIN

, California

Brief Legal Description

31 M&P 82, S.J.C.R.**CORNER TYPE****COORDINATES (Optional)**

- ☐ Government Corner ☐ Control
☐ Meander ☒ Property
☐ Rancho ☐ Other

Date of Survey June 11, 2026

N. _____ E. _____

Elevation _____

Units ☐ Metric ☐ U.S. Survey Foot

Horizontal Datum _____

Zone _____ Epoch Date _____

Vertical Datum _____

☐ Complies with Public Resources Code §§8801-8819☐ Complies with Public Resources Code §§8890-8902**T1N.,R6E., M.D.B.&M**

PLS Act Ref.:

☐ 8765(d)☒ 8771☐ 8773☐ Other:**Corner/
Monument:**☒ Left as found☐ Established☐ Rebuilt☒ Pre-Construction☐ Found and tagged☐ Reestablished☒ Referenced☐ Post-Construction

Narrative of corner identified and monument as found, set, reset, replaced, or removed:

☒ See sheet #2 for description(s):

FOUND CUT CROSS ON BACK OF WALK AT THE NORTHERLY CORNER COMMON TO LOT 15 AND 16 PER 31 M&P 82, SAN JOAQUIN COUNTY RECORDS.

SURVEYOR'S STATEMENT

This Corner Record was prepared by me or under my direction in conformance with

the Professional Land Surveyors' Act on July 9, 2026

Signed

(P.L.S.) or R.C.E. No.

8474**COUNTY SURVEYOR'S STATEMENT**

This Corner Record was received

July 16, 2026

and examined and filed

REBL July 21, 2026

Signed

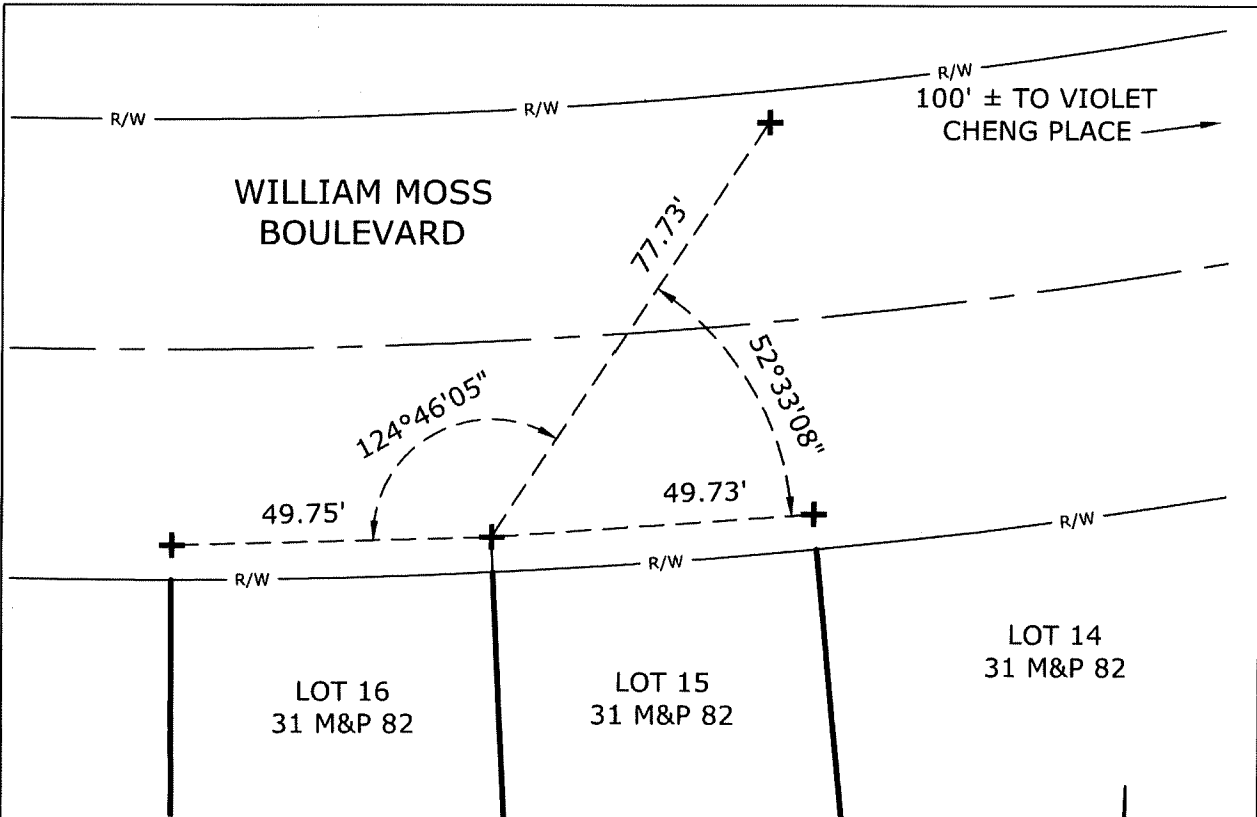
P.L.S. or R.C.E. No.

9728

Title

County Surveyor**County Surveyor's Comment**

35728571

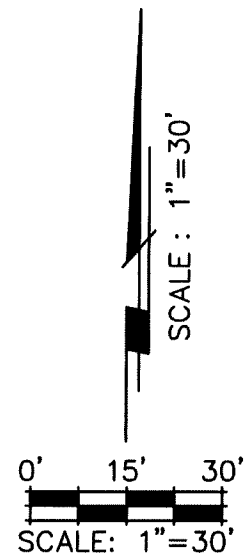
**LEGEND:**

✚ FOUND CUT '✚' ON BACK OF WALK

— R/W — RIGHT OF WAY

S.J.C.R. SAN JOAQUIN COUNTY RECORDS

M&P MAPS & PLATS

**REFERENCE(S):**

31 M&P 82, S.J.C.R.

NOTE: THE PURPOSE OF THIS CORNER RECORD IS TO PERPETUATE THE POSITION(S) OF EXISTING MONUMENT(S). NO REPRESENTATION IS MADE TO ANY RELATIVE POSITION(S) OF SAID MONUMENT(S). ALL RIGHT OF WAY, PROPERTY LINES, CENTERLINES AND OTHERS ARE FOR GRAPHICAL REPRESENTATION ONLY.



905 Sutter St. Suite 200 Folsom, CA 95630
(916) 366-3040 Fax (916) 366-3303
R. E. Y. ENGINEERS, Inc.
Civil Engineers / Land Surveyors

CORNER RECORD EXHIBIT MAP

SCALE: 1" = 30'
JOB NO: 35728571
DATE: 7/9/2026
DWG: 35728571.dwg