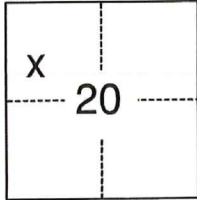


CORNER RECORD

Agency Index CR-26-248

Document Number _____

City of STOCKTON County of SAN JOAQUIN, CaliforniaBrief Legal Description 37 M&P 10, S.J.C.R.**CORNER TYPE****COORDINATES (Optional)**

- ☐ Government Corner ☐ Control
☐ Meander ☒ Property
☐ Rancho ☐ Other

Date of Survey June 12, 2026

N. _____ E. _____

Elevation _____

Units ☐ Metric ☒ U.S. Survey Foot

Horizontal Datum _____

Zone _____ Epoch Date _____

Vertical Datum _____

☐ Complies with Public Resources Code §§8801-8819☐ Complies with Public Resources Code §§8890-8902**T2N., R5E., M.D.B.&M**PLS Act Ref.: ☐ 8765(d) ☒ 8771 ☐ 8773 ☐ Other:

Corner/
Monument: ☒ Left as found ☐ Established ☐ Rebuilt ☒ Pre-Construction
☐ Found and tagged ☐ Reestablished ☒ Referenced ☐ Post-Construction

Narrative of corner identified and monument as found, set, reset, replaced, or removed:

☒ See sheet #2 for description(s):

FOUND 3/4" IRON PIPE WITH CAP STAMPED "L.S. 6953" AT THE NORTHERLY ANGLE POINT OF LOT "J" PER 37 M&P 10, SAN JOAQUIN COUNTY RECORDS.


SURVEYOR'S STATEMENT

This Corner Record was prepared by me or under my direction in conformance with

the Professional Land Surveyors' Act on July 8, 2026Signed [Signature] (P.L.S.) or R.C.E. No. 8474**COUNTY SURVEYOR'S STATEMENT**This Corner Record was received July 16, 2026and examined and filed July 21, 2026Signed [Signature] P.L.S. or R.C.E. No. 9728Title County Surveyor

County Surveyor's Comment _____

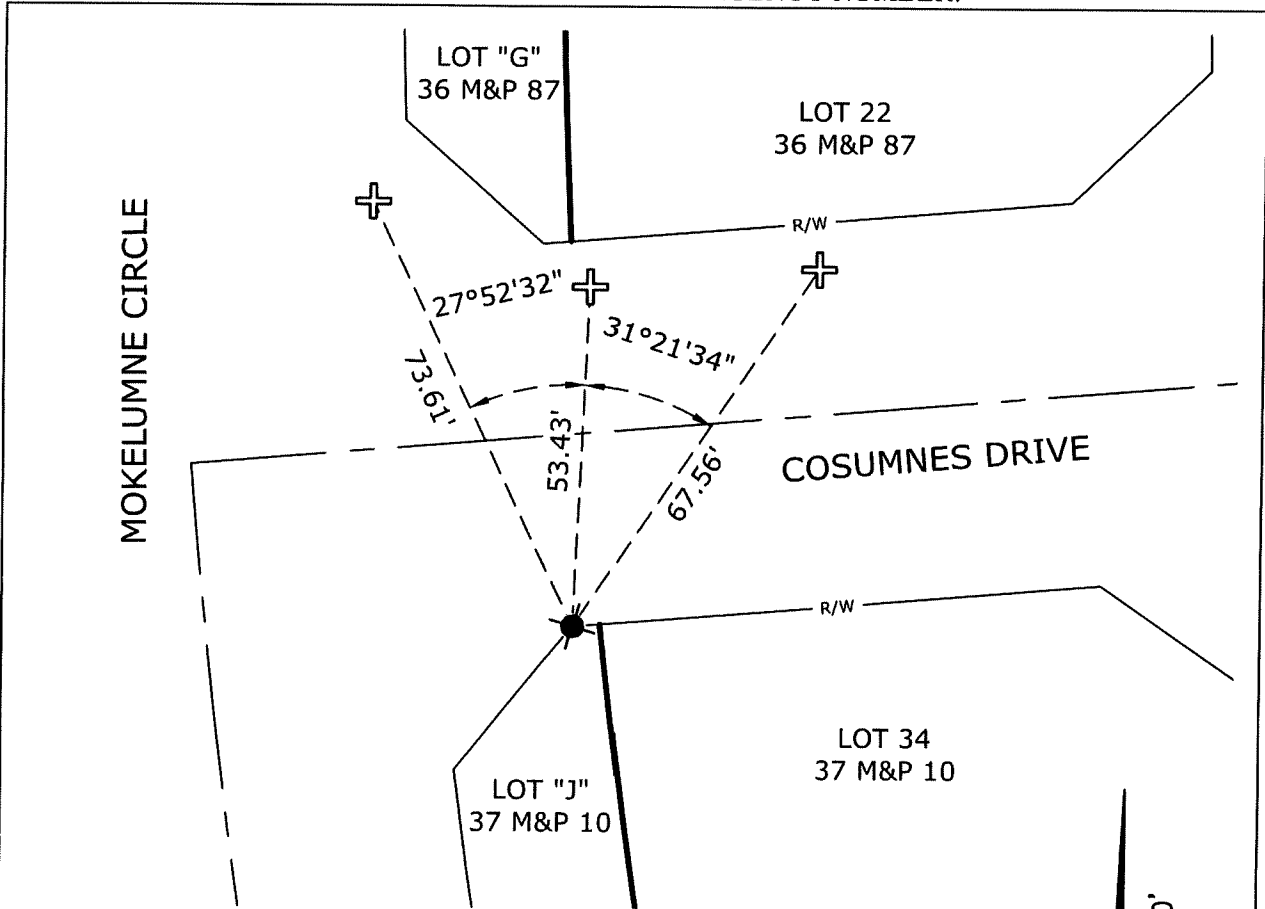

**LEGEND:**

FOUND 3/4" IRON PIPE W/ PLUG MARKED "LS 6953"




SET CUT '+' ON BACK OF WALK

— R/W — RIGHT OF WAY

S.J.C.R. SAN JOAQUIN COUNTY RECORDS

M&P MAPS & PLATS

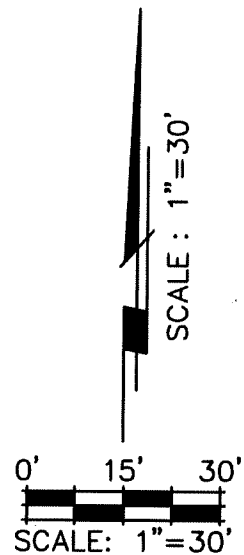**REFERENCE(S):**

37 M&P 10, S.J.C.R.

NOTE: THE PURPOSE OF THIS CORNER RECORD IS TO PERPETUATE THE POSITION(S) OF EXISTING MONUMENT(S). NO REPRESENTATION IS MADE TO ANY RELATIVE POSITION(S) OF SAID MONUMENT(S). ALL RIGHT OF WAY, PROPERTY LINES, CENTERLINES AND OTHERS ARE FOR GRAPHICAL REPRESENTATION ONLY.



906 Sutter St. Suite 200, Folsom, CA 95630
 (916) 356-3040 Fax: (916) 356-3303
 R.E.Y. ENGINEERS, Inc.
 Civil Engineers and Surveyors

CORNER RECORD EXHIBIT MAP

SCALE: 1" = 30'

JOB NO: 35735560

DATE: 7/8/2026

DWG: 35728571.dwg