


CORNER RECORD

Agency Index CR-26-252
Document Number _____

City of Lodi County of San Joaquin, California
Brief Legal Description Property monuments at Connie Street & Hutchins Street

CORNER TYPE

COORDINATES (Optional)

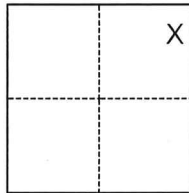

- ☐ Government Corner ☐ Control
☐ Meander ☒ Property
☐ Rancho ☐ Other

Date of Survey April 23, 2026

N. _____ E. _____

Elevation _____

Units ☐ Metric ☒ U.S. Survey Foot

Horizontal Datum _____

Zone _____ Epoch Date _____

Vertical Datum _____

☐ Complies with Public Resources Code §§8801-8819

☐ Complies with Public Resources Code §§8890-8902

Section 11, T.3N., R.6E.
M.D.B.&M.

PLS Act Ref.: ☐ 8765(d) ☒ 8771 ☐ 8773 ☐ Other:
Corner/
Monument: ☒ Left as found ☐ Established ☐ Rebuilt ☒ Pre-Construction
☐ Found and tagged ☐ Reestablished ☒ Referenced ☐ Post-Construction

Narrative of corner identified and monument as found, set, reset, replaced, or removed:

☒ See sheet #2 for description(s):

FOUND UNTAGGED MONUMENTS PER M&P 16-18 AT THE SOUTHWEST CORNER OF CONNIE STREET AND HUTCHINS STREET. SET THREE (3) NAILS WITH WASHERS, STAMPED "C.O.L. LS 9478" AS REFERENCE POINTS. NO BOUNDARY ANALYSIS WAS PERFORMED.

SURVEYOR'S STATEMENT

This Corner Record was prepared by me or under my direction in conformance with

the Professional Land Surveyors' Act on 7-22-26

Signed [Signature] P.L.S. or R.C.E. No. 9478



COUNTY SURVEYOR'S STATEMENT

This Corner Record was received July 23, 2026


and examined and filed August 3, 2026

Signed [Signature] P.L.S. or R.C.E. No. 9728

Title County Surveyor

County Surveyor's Comment

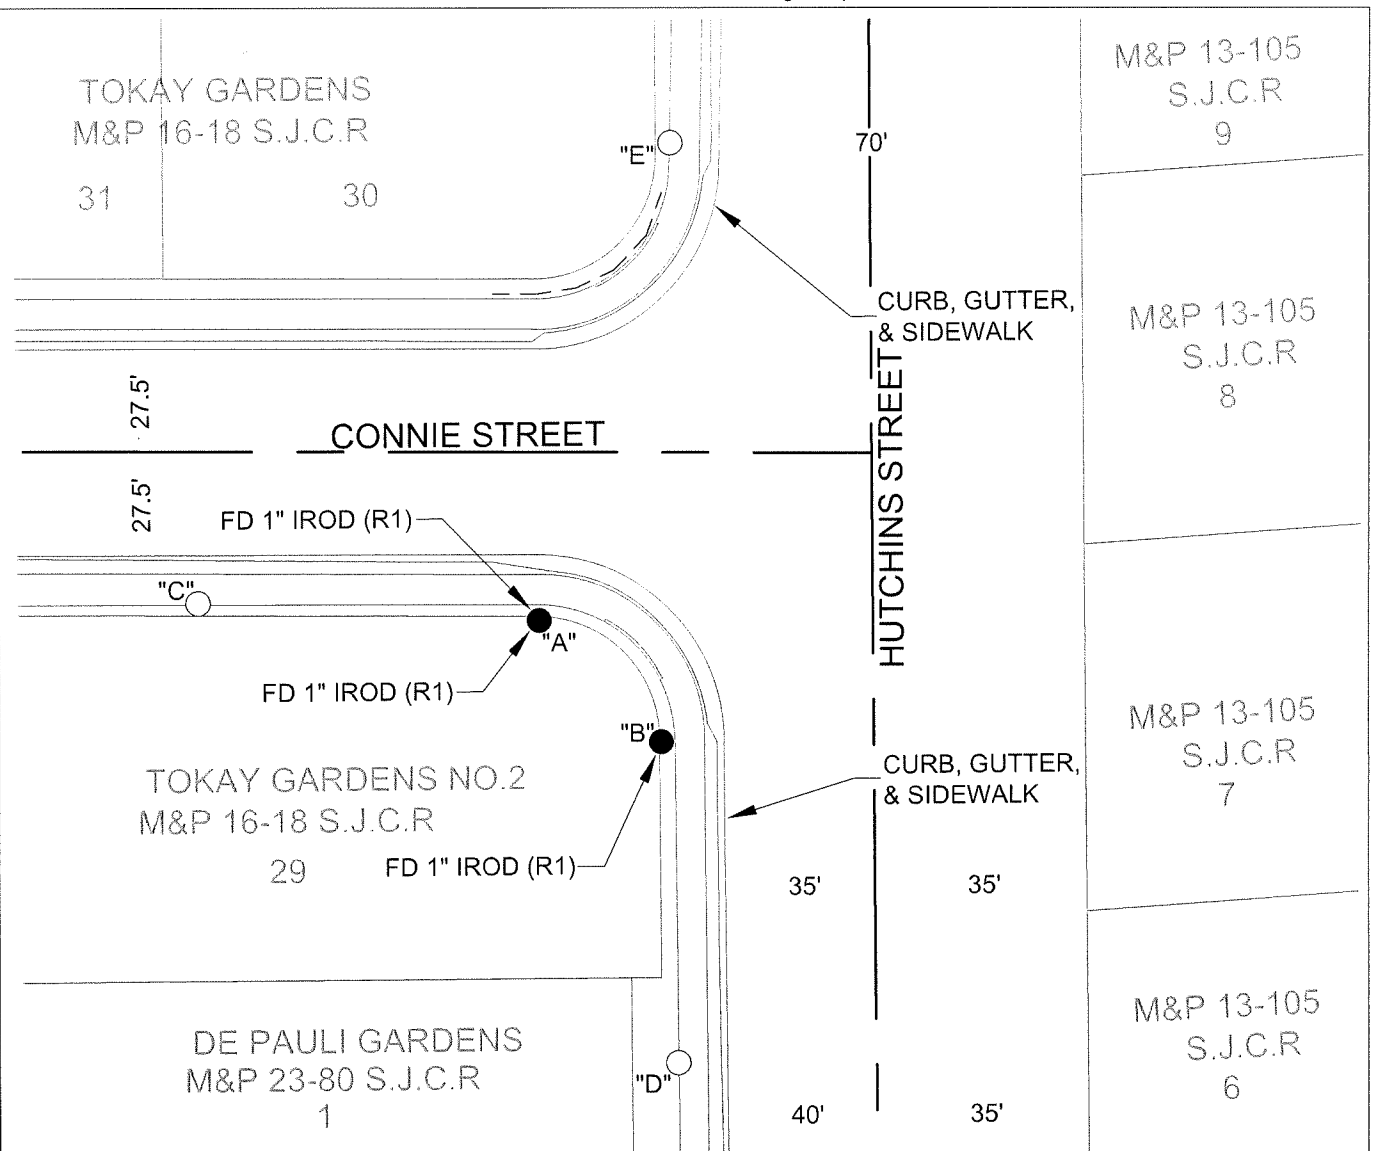

**DISTANCE (M) TABLE**


	FD MONUMENT	FROM	DISTANCE	FROM2	DISTANCE2	FROM3	DISTANCE3
"A"	FOUND UNTAGGED 1" IRON ROD	"C"	56.21'	"D"	76.16'	"E"	80.84'
"B"	FOUND UNTAGGED 1" IRON ROD	"C"	79.49'	"D"	52.82'	"E"	97.85'

LEGEND

- FOUND MONUMENT AS NOTED IN TABLE
- FOUND NAIL AND WASHER STAMPED "C. O. L. LS 9478"
- M&P MAPS & PLATS, VOLUME & PAGE, S.J.C.R
- FD FOUND
- IROD IRON ROD
- (M) MEASURED ON THIS SURVEY
- S.J.C.R. SAN JOAQUIN COUNTY RECORDS

REFERENCES

(R1) M&P 16-18 S.J.C.R.

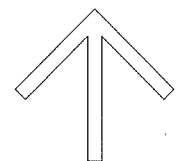**NORTH**SCALE: 1"=30'
2404-CR.DWG