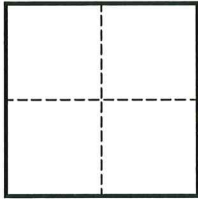


CORNER RECORD

Agency Index

CR-26-256

Document Number

City of _____ County of SAN JOAQUIN CaliforniaBrief Legal Description FOUND MONUMENT AT THE INTERSECTION OF BASIN STREET AND DIXIE DRIVE**CORNER TYPE****COORDINATES (Optional)**

- ☐ Government Corner ☐ Control
☐ Meander ☐ Property
☐ Rancho ☒ Other

Date of Survey MARCH 7, 2025

N. _____ E. _____

Elevation _____

Units ☐ Metric ☐ U.S. Survey Foot

Horizontal Datum _____

Zone _____ Epoch Date _____

Vertical Datum _____

☐ Complies with Public Resources Code §§8801-8819☐ Complies with Public Resources Code §§8890-8902PLS Act Ref.: ☐ 8765(d) ☒ 8771 ☐ 8773 ☐ Other:

Corner/
Monument: ☒ Left as found ☐ Established ☐ Rebuilt ☐ Pre-Construction
☐ Found and tagged ☐ Reestablished ☒ Referenced ☒ Post-Construction

Narrative of corner identified and monument as found, set, reset, replaced, or removed:

☐ See sheet #2 for description(s):

FOUND 3/4" IRON ROD IN MONUMENT WELL AT THE INTERSECTION OF BASIN STREET AND DIXIE DRIVE
PER CR 16-442, SAN JOAQUIN COUNTY SURVEYOR'S RECORDS.

THE MONUMENT WAS FOUND AS UNDISTURBED FOLLOWING CONSTRUCTION OF A WATERLINE
PROJECT DONE BY WEST VALLEY CONSTRUCTION COMPANY.

SURVEYOR'S STATEMENT


This Corner Record was prepared by me or under my direction in conformance with
the Professional Land Surveyors' Act on 7/17/2026

Signed _____ P.L.S. or R.C.E. No. 9592**COUNTY SURVEYOR'S STATEMENT**

This Corner Record was received

and examined and filed

Signed Robert L. Borsdorf III P.L.S. or R.C.E. No. 9728Title County Surveyor**County Surveyor's Comment**

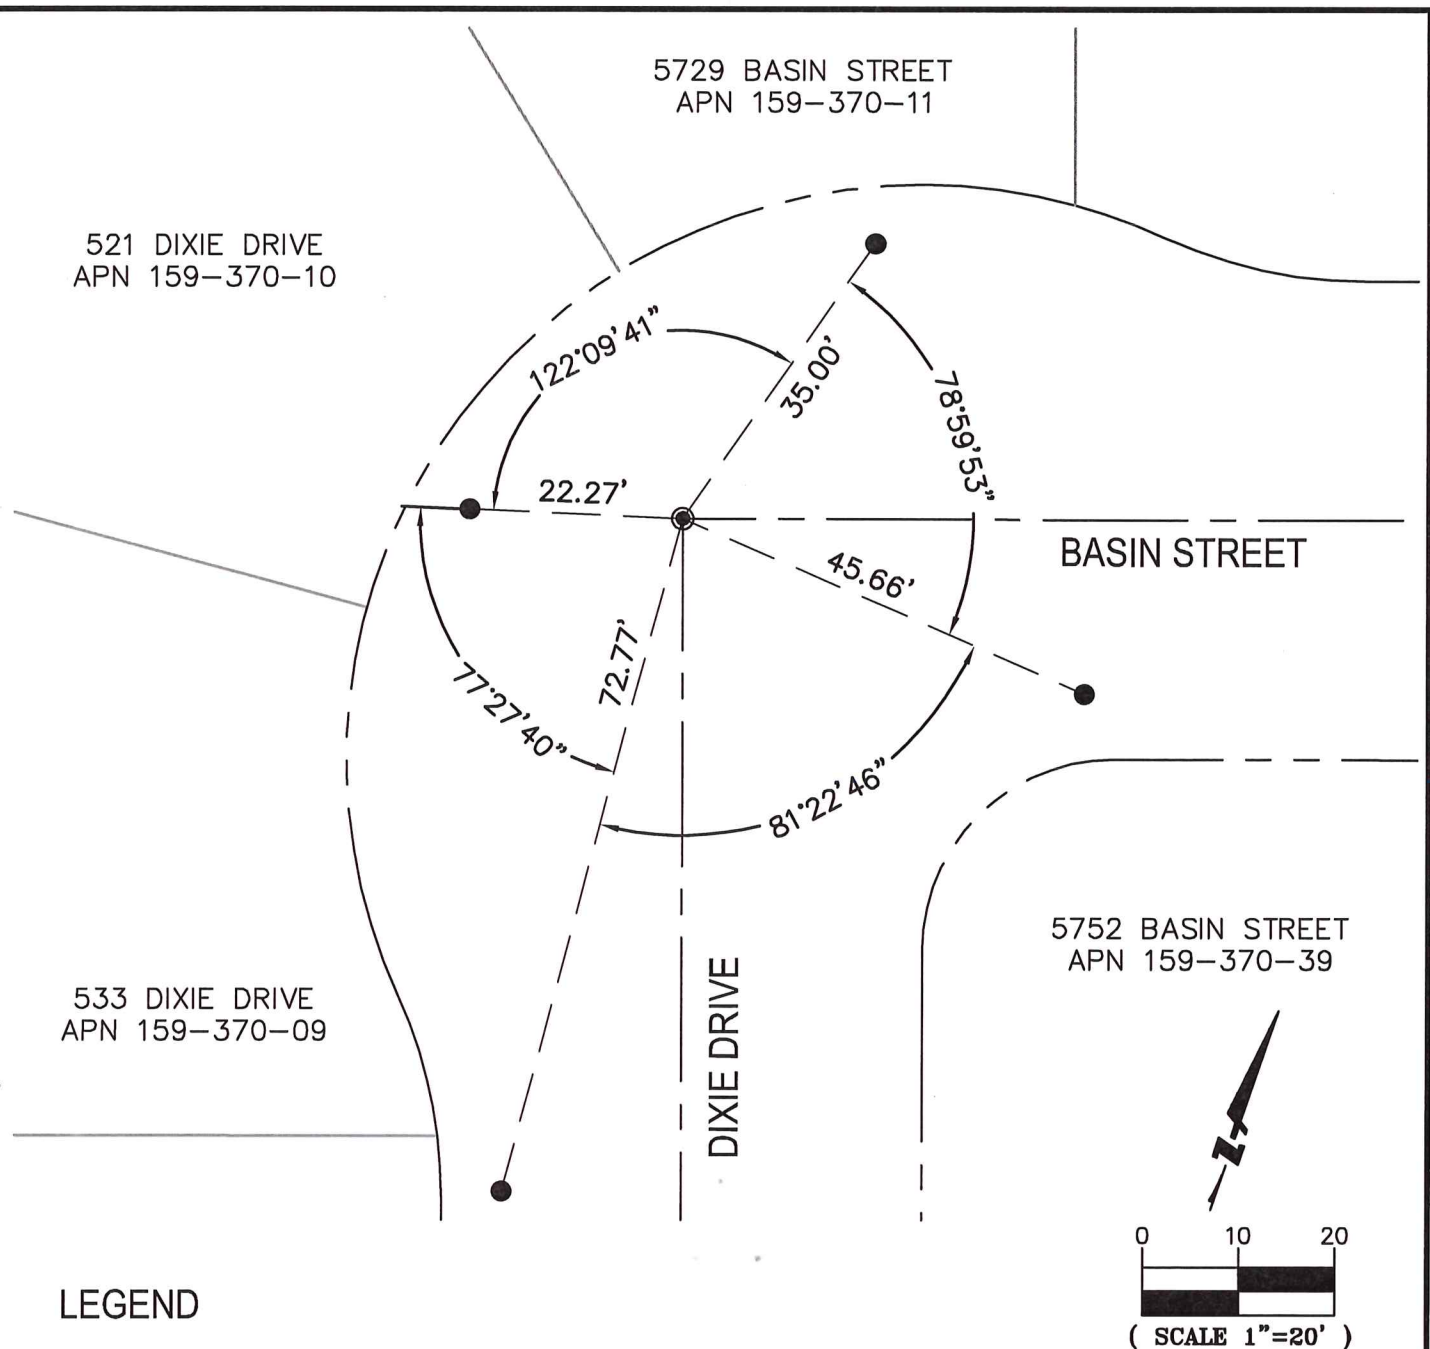

LEGEND

- FOUND 3/4" IRON ROD IN MONUMENT WELL AT THE INTERSECTION OF BASIN STREET AND DIXIE DRIVE PER CR 16-442, SAN JOAQUIN COUNTY SURVEYOR'S RECORDS.
- FOUND MAG AND WASHER STAMPED "BKF SURVEY LS 6868" AT BACK OF ROLLED CURB PER CR-25-396, SAN JOAQUIN COUNTY SURVEYOR'S RECORDS.

APN ASSESSOR'S PARCEL NUMBER.

CR CORNER RECORD.



1730 N. FIRST STREET
SUITE 600
SAN JOSE, CA 95112
408-467-9100
www.bkf.com

Subject POST-CONSTRUCTION CORNER RECORD AT
INTERSECTION OF BASIN STREET AND DIXIE DRIVE

Job No. 20191483-382 - MON PRESERVATION

By GA Date 04-22-2025 Chkd. RV
SHEET 2 OF 2