

# CORNER RECORD

Agency Index

CR-26-263

Document Number

City of STOCKTON

County of SAN JOAQUIN, California

Brief Legal Description CARRIE STREET BETWEEN GEN. MUELLER LANE AND HAT COURT



T.1N., R.6E.

## CORNER TYPE

- |                                            |                                              |
|--------------------------------------------|----------------------------------------------|
| <input type="checkbox"/> Government Corner | <input type="checkbox"/> Control             |
| <input type="checkbox"/> Meander           | <input checked="" type="checkbox"/> Property |
| <input type="checkbox"/> Rancho            | <input type="checkbox"/> Other               |

Date of Survey 1-30-26

## COORDINATES (Optional)

N. \_\_\_\_\_ E. \_\_\_\_\_  
Elevation \_\_\_\_\_  
Units ☐ Metric ☐ U.S. Survey Foot  
Horizontal Datum \_\_\_\_\_  
Zone \_\_\_\_\_ Epoch Date \_\_\_\_\_  
Vertical Datum \_\_\_\_\_

☐ Complies with Public Resources Code §§8801-8819☐ Complies with Public Resources Code §§8890-8902PLS Act Ref: ☐ 8765(d) ☒ 8771 ☐ 8773 ☐ Other:

|                      |                                                   |                                                   |                                     |                                                       |
|----------------------|---------------------------------------------------|---------------------------------------------------|-------------------------------------|-------------------------------------------------------|
| Corner/<br>Monument: | <input checked="" type="checkbox"/> Left as found | <input type="checkbox"/> Established              | <input type="checkbox"/> Rebuilt    | <input type="checkbox"/> Pre-Construction             |
|                      | <input type="checkbox"/> Found and tagged         | <input checked="" type="checkbox"/> Reestablished | <input type="checkbox"/> Referenced | <input checked="" type="checkbox"/> Post-Construction |

Narrative of corner identified and monument as found, set, reset, replaced, or removed:

☐ See sheet #2 for description (s):

FOUND FOUR (4) CONCRETE NAILS WITH BRASS TAG "LS 9857" AS WITNESS CORNERS PER (R1); SET ONE (1) CONCRETE NAIL WITH BRASS TAG "LS 9857", ALL AS SHOWN ON SHEET 2.

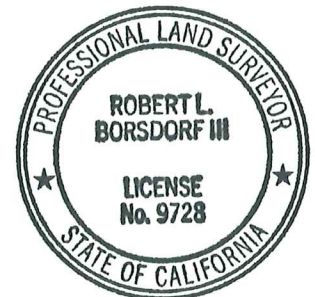
## SURVEYOR'S STATEMENT

This Corner Record was prepared by me or under my direction in conformance with the Professional Land Surveyors' Act on JULY 17, 2026

Signed Tanya Cissell P.L.S. or R.C.E. No. 9857

## COUNTY SURVEYOR'S STATEMENT

This Corner Record was received July 20, 2026  
and examined and filed August 6, 2026

Signed Robert L. Borsdorf III P.L.S. or R.C.E. No. 9728Title County Surveyor

County Surveyor's Comment

