

CORNER RECORD

Agency Index


CR-26-264

Document Number

City of STOCKTON

County of SAN JOAQUIN, California

Brief Legal Description W. FREMONT STREET BETWEEN EDISON STREET AND HARRISON STREET

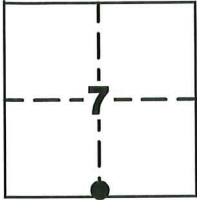C.M. WEBER
GRANT**CORNER TYPE**

- | | |
|--|--|
| ☐ Government Corner | ☐ Control |
| ☐ Meander | ☒ Property |
| ☐ Rancho | ☐ Other |

Date of Survey 1-30-26

COORDINATES (Optional)

N. _____ E. _____
Elevation _____
Units ☐ Metric ☐ U.S. Survey Foot
Horizontal Datum _____
Zone _____ Epoch Date _____
Vertical Datum _____

☐ Complies with Public Resources Code §§8801-8819☐ Complies with Public Resources Code §§8890-8902PLS Act Ref: ☐ 8765(d) ☒ 8771 ☐ 8773 ☐ Other:

Corner/ Monument:	☒ Left as found	☐ Established	☐ Rebuilt	☐ Pre-Construction
	☐ Found and tagged	☒ Reestablished	☐ Referenced	☒ Post-Construction

Narrative of corner identified and monument as found, set, reset, replaced, or removed:

☐ See sheet #2 for description (s):

FOUND THREE (3) CONCRETE NAILS WITH BRASS TAG "LS 9857" AS WITNESS CORNERS PER (R1),
FOUND ONE (1) CUT "+" NO TAG PER (R1); SET ONE (1) CONCRETE NAIL WITH BRASS TAG
"LS 9857" AS WITNESS CORNER, ALL AS SHOWN ON SHEET 2.

SURVEYOR'S STATEMENT

This Corner Record was prepared by me or under my direction in conformance with
the Professional Land Surveyors' Act on JULY 17, 2026

Signed Tanya Cissell P.L.S. or R.C.E. No. 9857**COUNTY SURVEYOR'S STATEMENT**

This Corner Record was received

JULY 20, 2026

and examined and filed

AUGUST 6, 2026

Signed

R. B. L. III

P.L.S. or R.C.E. No.


9728

Title

County Surveyor



County Surveyor's Comment

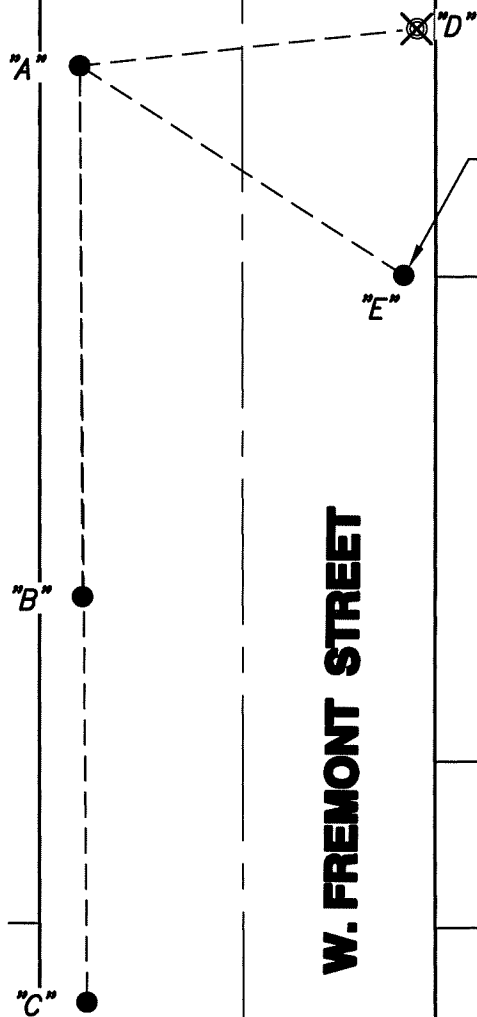

FOUND CUT "+" IN WALK, NO TAG (R1)

38-S-200

SCALE: 1" = 30'

∠ AND DISTANCE TABLE

BS-@-FS	∠	FS DISTANCE
C-A-C	00°00'00"	146.70'(M)
C-A-B	00°07'48"	83.15'(M)
C-A-D	264°13'58"	53.18'(M)
C-A-E	303°17'16"	60.56'(M)

REFERENCES:

(R1) CR-26-135, S.J.C.S.R.

NOTE:

THIS CORNER RECORD DOES NOT VERIFY THIS MONUMENT TO BE IN THE CORRECT POSITION.

LEGEND:



SET CONCRETE NAIL WITH BRASS TAG "LS 9857".



FOUND CONCRETE NAIL WITH BRASS TAG "LS 9857" UNLESS OTHERWISE NOTED.

-S- RECORD OF SURVEY, S.J.C.R.

-CR- CORNER RECORDS, S.J.C.S.R.

S.J.C.R. SAN JOAQUIN COUNTY RECORDS

S.J.C.S.R. SAN JOAQUIN COUNTY SURVEYOR'S RECORDS

(M) MEASURED DISTANCE. ALL DISTANCES ARE MEASURED UNLESS NOTED OTHERWISE.

EDISON STREET