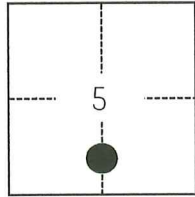


CORNER RECORD

Agency Index

CR-26-286

Document Number

City of STOCKTON County of SAN JOAQUIN, CaliforniaBrief Legal Description FOUND MONUMENTS UNDISTURBED IN RIVERSIDE COURT AND ALONG OREGON AVENUE AS SHOWN ON CORNER RECORD 26-161, SAN JOAQUIN COUNTY RECORDS.**CORNER TYPE****COORDINATES (Optional)**

T1N/R6E

- ☐ Government Corner ☐ Control
☐ Meander ☒ Property
☐ Rancho ☐ Other

Date of Survey JUNE 11, 2026

N. _____ E. _____

Elevation _____

Units ☐ Metric ☒ U.S. Survey Foot

Horizontal Datum _____

Zone _____ Epoch Date _____

Vertical Datum _____

☐ Complies with Public Resources Code §§8801-8819☐ Complies with Public Resources Code §§8890-8902

PLS Act Ref.:

☐ 8765(d)☒ 8771☐ 8773☐ Other:Corner/
Monument:☒ Left as found☐ Established☐ Rebuilt☐ Pre-Construction☐ Found and tagged☐ Reestablished☒ Referenced☒ Post-Construction

Narrative of corner identified and monument as found, set, reset, replaced, or removed:

☒ See sheet #2 for description(s):

THE FOUND MONUMENT(S) SHOWN ON THIS CORNER RECORD WERE FOUND IN THE LOCATION OF THE CORNER(S) ON CORNER RECORD 26-161 SAN JOAQUIN COUNTY RECORDS. I DID NOT VERIFY THE IDENTITY AND VALIDITY OF THE MONUMENT(S) FOUND AS ACTUALLY MARKING THE PROPERTY CORNER.

SURVEYOR'S STATEMENT

This Corner Record was prepared by me or under my direction in conformance with

the Professional Land Surveyors' Act on JUNE 16, 2026

Signed

P.L.S. or R.C.E. No.

8489**COUNTY SURVEYOR'S STATEMENT**

This Corner Record was received

August 11, 2026

and examined and filed

August 24, 2026

Signed


P.L.S. or R.C.E. No.



9728

Title

County Surveyor

County Surveyor's Comment

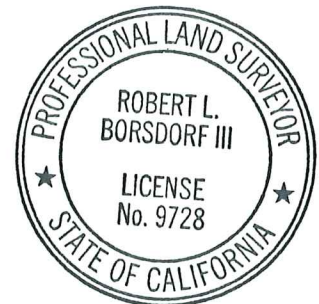

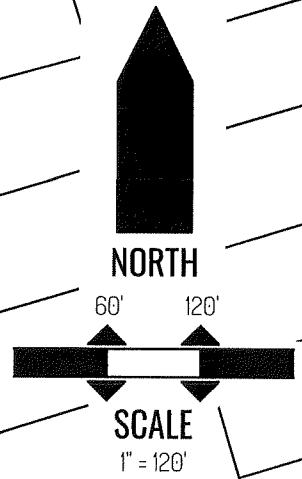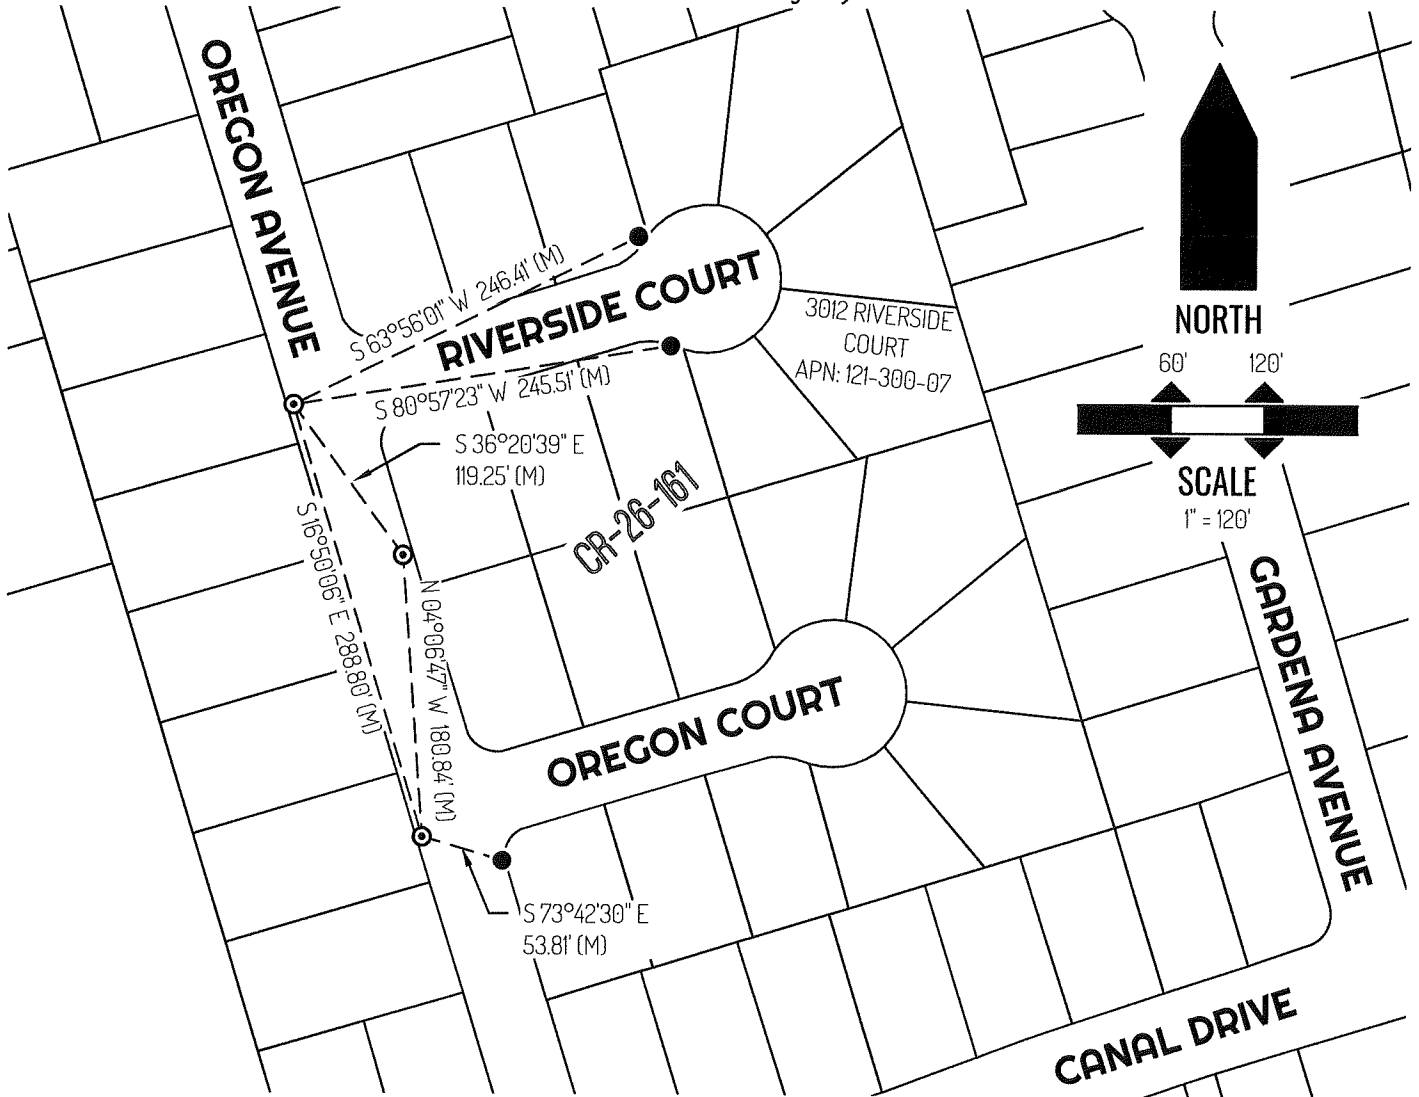

LEGEND

●	FOUND 3/4" IRON PIN PER (A) NO CAP OR TAG UNDISTURBED
⊙	FOUND BRASS PLUG STAMPED "RH CONTROL" PER (A) UNDISTURBED
3012	REFERENCE STREET ADDRESS
APN	TAX ASSESSOR PARCEL NUMBER
(M)	MEASURED
---	TIE LINE
---	LOT LINE

REFERENCE

(A) CORNER RECORD 26-161, SAN JOAQUIN COUNTY SURVEYOR'S RECORDS