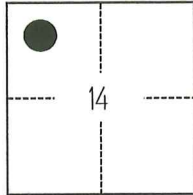


CORNER RECORD

Agency Index

CR-26-287

Document Number

City of STOCKTON County of SAN JOAQUIN, CaliforniaBrief Legal Description FOUND MONUMENT ON THE SOUTH SIDE OF ENCINO AVENUE NEAR THE INTERSECTION WITH THORNTON ROAD AS SHOWN ON CORNER RECORD 26-168, SAN JOAQUIN COUNTY SURVEYOR'S RECORDS.**CORNER TYPE****COORDINATES (Optional)**

T2N/R6E

- ☐ Government Corner ☐ Control
☐ Meander ☒ Property
☐ Rancho ☐ Other

Date of Survey JUNE 10, 2026

N. _____ E. _____

Elevation _____

Units ☐ Metric ☒ U.S. Survey Foot

Horizontal Datum _____

Zone _____ Epoch Date _____

Vertical Datum _____

☐ Complies with Public Resources Code §§8801-8819☐ Complies with Public Resources Code §§8890-8902

PLS Act Ref.:

☐ 8765(d)☒ 8771☐ 8773☐ Other:Corner/
Monument:☒ Left as found☐ Established☐ Rebuilt☐ Pre-Construction☐ Found and tagged☐ Reestablished☒ Referenced☒ Post-Construction

Narrative of corner identified and monument as found, set, reset, replaced, or removed:

☒ See sheet #2 for description(s):

THE FOUND MONUMENT SHOWN ON THIS CORNER RECORD WAS FOUND IN THE LOCATION OF THE CORNER ON CORNER RECORD 26-168, SAN JOAQUIN COUNTY SURVEYOR'S RECORDS. I DID NOT VERIFY THE IDENTITY AND VALIDITY OF THE MONUMENT FOUND AS ACTUALLY MARKING THE PROPERTY CORNER.

SURVEYOR'S STATEMENT

This Corner Record was prepared by me or under my direction in conformance with

the Professional Land Surveyors' Act on JUNE 17, 2026

Signed

P.L.S. or R.C.E. No.

8489**COUNTY SURVEYOR'S STATEMENT**

This Corner Record was received

August 11, 2026

and examined and filed

August 24, 2026

Signed

P.L.S. or R.C.E. No.

9728

Title



County Surveyor

County Surveyor's Comment



Document Number

Agency Index

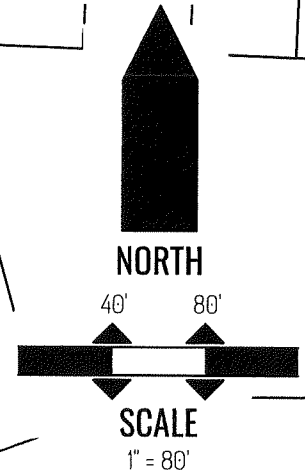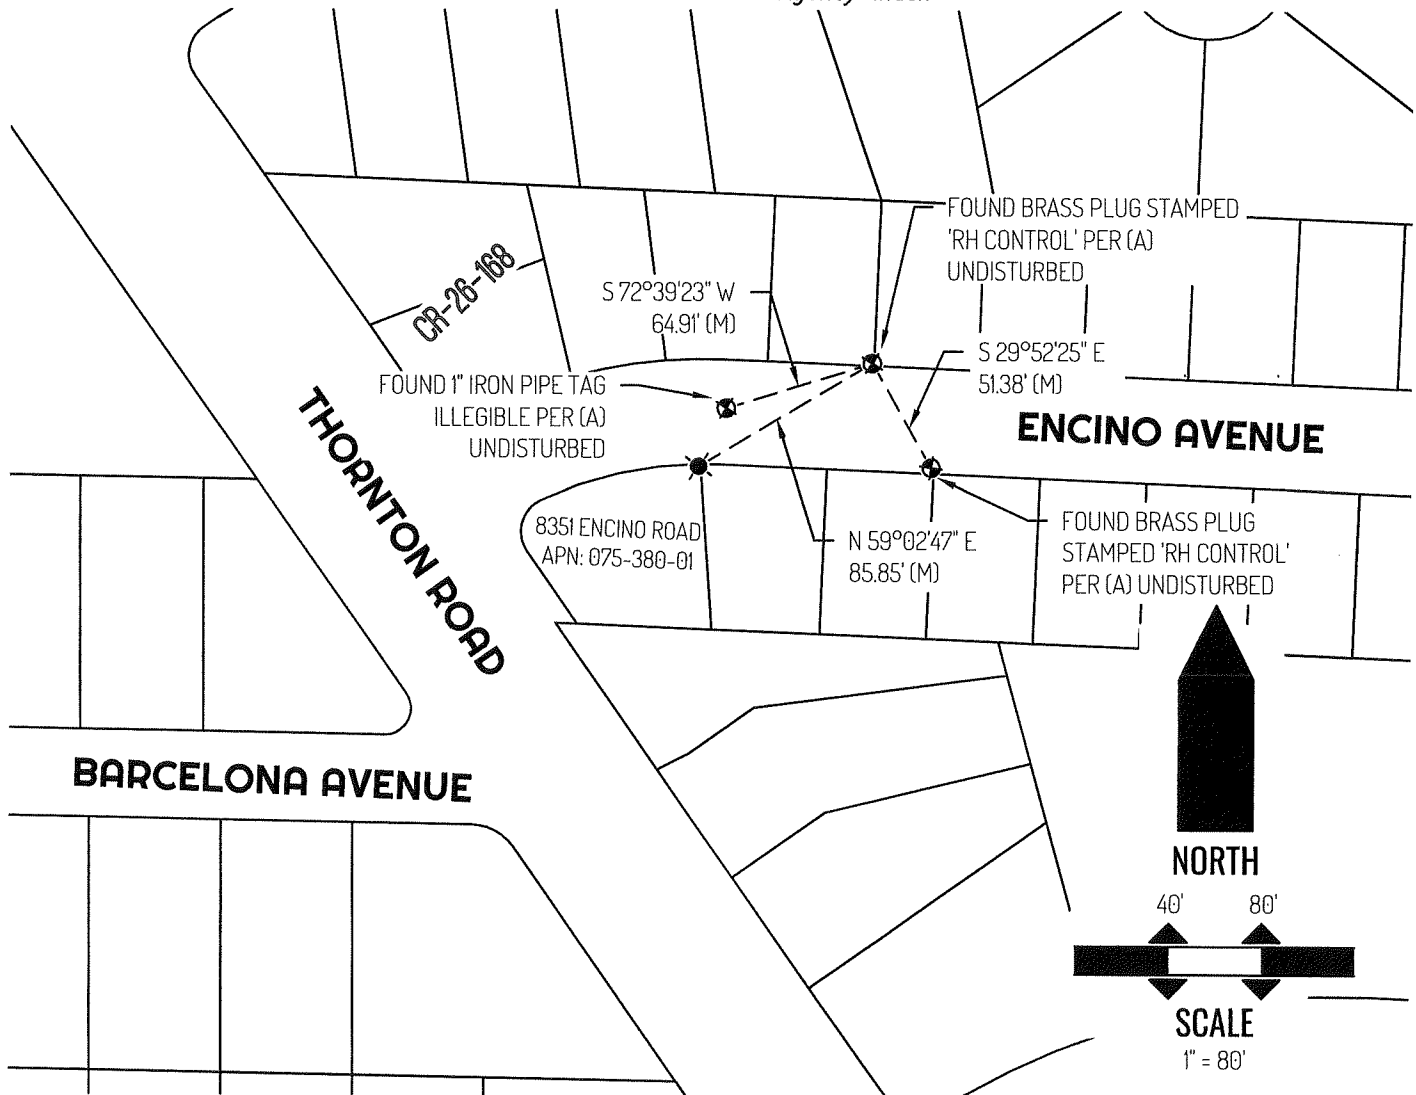

LEGEND

	FOUND CONTROL POINT AS NOTED
	FOUND CHISELED CROSS PER (A) UNDISTURBED
8351	REFERENCE STREET ADDRESS
CR	CORNER RECORD, SAN JOAQUIN COUNTY SURVEYOR'S RECORDS
APN	TAX ASSESSOR PARCEL NUMBER
(M)	MEASURED
---	TIE LINE
---	LOT LINE

REFERENCE

(A) CORNER RECORD 26-168, SAN JOAQUIN COUNTY SURVEYOR'S RECORDS