


CORNER RECORD

Agency Index CR-26-288
Document Number _____

City of STOCKTON County of SAN JOAQUIN, California
Brief Legal Description FOUND MONUMENT SHOWN ON CORNER RECORD 25-459, SAN JOAQUIN COUNTY SURVEYOR'S RECORDS.

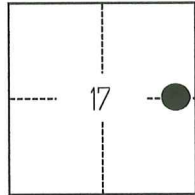

T2N/R6E

CORNER TYPE

- ☐ Government Corner ☐ Control
☐ Meander ☒ Property
☐ Rancho ☐ Other

Date of Survey JUNE 8, 2026

COORDINATES (Optional)

N. _____ E. _____
Elevation _____
Units ☐ Metric ☒ U.S. Survey Foot
Horizontal Datum _____
Zone _____ Epoch Date _____
Vertical Datum _____
☐ Complies with Public Resources Code §§8801-8819
☐ Complies with Public Resources Code §§8890-8902

PLS Act Ref.:	☐ 8765(d)	☒ 8771	☐ 8773	☐ Other:
Corner/ Monument:	☒ Left as found	☐ Established	☐ Rebuilt	☐ Pre-Construction
	☐ Found and tagged	☐ Reestablished	☒ Referenced	☒ Post-Construction

Narrative of corner identified and monument as found, set, reset, replaced, or removed:

☒ See sheet #2 for description(s):

THE FOUND MONUMENT SHOWN ON THIS CORNER RECORD WAS FOUND IN THE LOCATION OF THE MONUMENT ON CR 25-459, SAN JOAQUIN COUNTY SURVEYOR'S RECORDS. I DID NOT VERIFY THE IDENTITY AND VALIDITY OF THE MONUMENT FOUND AS ACTUALLY MARKING THE PROPERTY CORNER.

SURVEYOR'S STATEMENT

This Corner Record was prepared by me or under my direction in conformance with

the Professional Land Surveyors' Act on JUNE 13, 2026.

Signed [Signature] P.L.S. or R.C.E. No. 8489



COUNTY SURVEYOR'S STATEMENT


This Corner Record was received August 11, 2026

and examined and filed August 24, 2026

Signed [Signature] P.L.S. or R.C.E. No. 9728


Title County Surveyor

County Surveyor's Comment

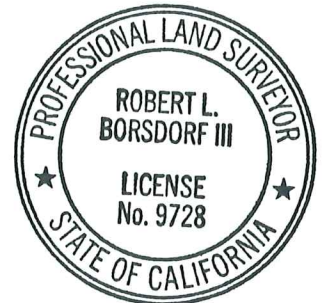

Document Number

Agency Index

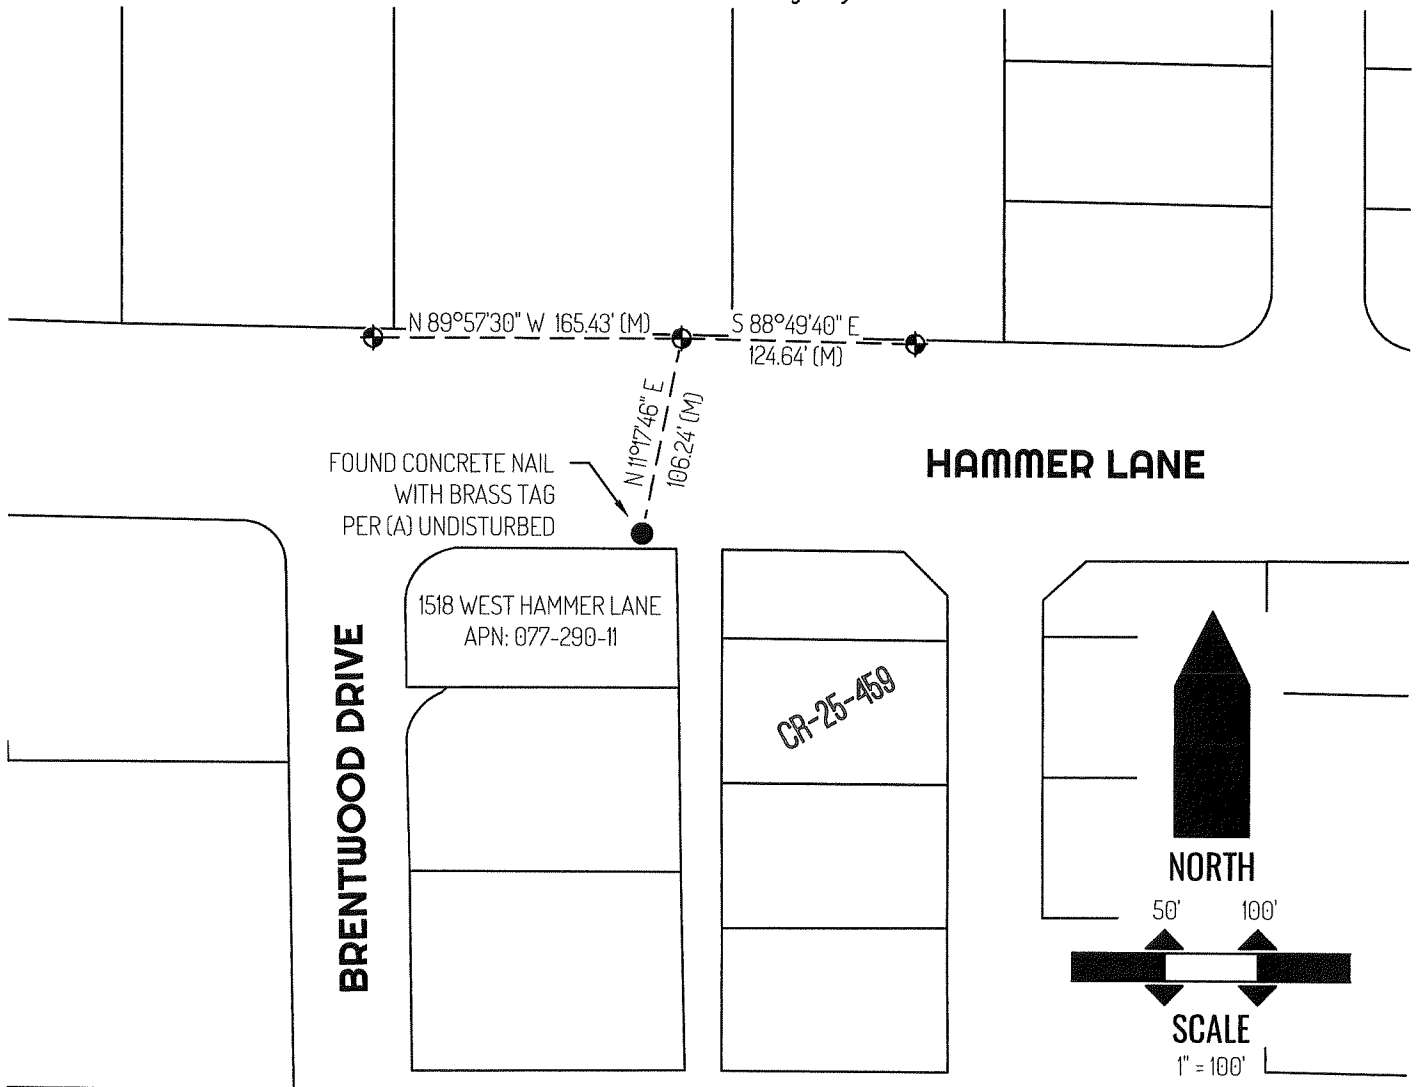

LEGEND

●	FOUND MONUMENT AS NOTED
⊕	FOUND BRASS PLUG STAMPED "RH CONTROL" PER (A) UNDISTURBED
1518	REFERENCE STREET ADDRESS
CR	CORNER RECORD, SAN JOAQUIN COUNTY SURVEYOR'S RECORDS
APN	TAX ASSESSOR PARCEL NUMBER
(M)	MEASURED
---	TIE LINE
---	LOT LINE

REFERENCE

(A) CORNER RECORD 25-459, SAN JOAQUIN COUNTY SURVEYOR'S RECORDS