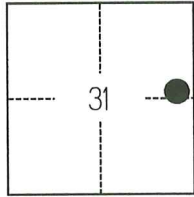


CORNER RECORD

Agency Index

CR-26-289

Document Number

City of _____ County of SAN JOAQUIN, CaliforniaBrief Legal Description FOUND MONUMENTS ON CORRAL HOLLOW ROAD PER CORNER RECORD 25-282, SAN JOAQUIN COUNTY SURVEYOR'S RECORDS.**CORNER TYPE****COORDINATES (Optional)**

T2S/R5E

- | | |
|--|--|
| ☐ Government Corner | ☐ Control |
| ☐ Meander | ☒ Property |
| ☐ Rancho | ☐ Other |

Date of Survey MAY 26, 2026

N. _____ E. _____

Elevation _____

Units ☐ Metric ☒ U.S. Survey Foot

Horizontal Datum _____

Zone _____ Epoch Date _____

Vertical Datum _____

☐ Complies with Public Resources Code §§8801-8819☐ Complies with Public Resources Code §§8890-8902

PLS Act Ref.:

☐ 8765(d)☒ 8771☐ 8773☐ Other:Corner/
Monument:☒ Left as found☐ Established☐ Rebuilt☐ Pre-Construction☐ Found and tagged☐ Reestablished☒ Referenced☒ Post-Construction

Narrative of corner identified and monument as found, set, reset, replaced, or removed:

☒ See sheet #2 for description(s):

THE FOUND MONUMENT(S) SHOWN ON THIS CORNER RECORD WERE FOUND AT THE LOCATION OF THE CORNER(S) ON CORNER RECORD 25-282, SAN JOAQUIN COUNTY SURVEYOR'S RECORDS. I DID NOT VERIFY THE IDENTITY AND VALIDITY OF THE MONUMENT(S) FOUND AS ACTUALLY MARKING THE PROPERTY CORNER.

SURVEYOR'S STATEMENT

This Corner Record was prepared by me or under my direction in conformance with

the Professional Land Surveyors' Act on MAY 27, 2026

Signed

P.L.S. or R.C.E. No.

8489**COUNTY SURVEYOR'S STATEMENT**

This Corner Record was received


and examined and filed

Signed

August 12, 2026
August 24, 2026
 III P.L.S. or R.C.E. No. 9728
County Surveyor

County Surveyor's Comment



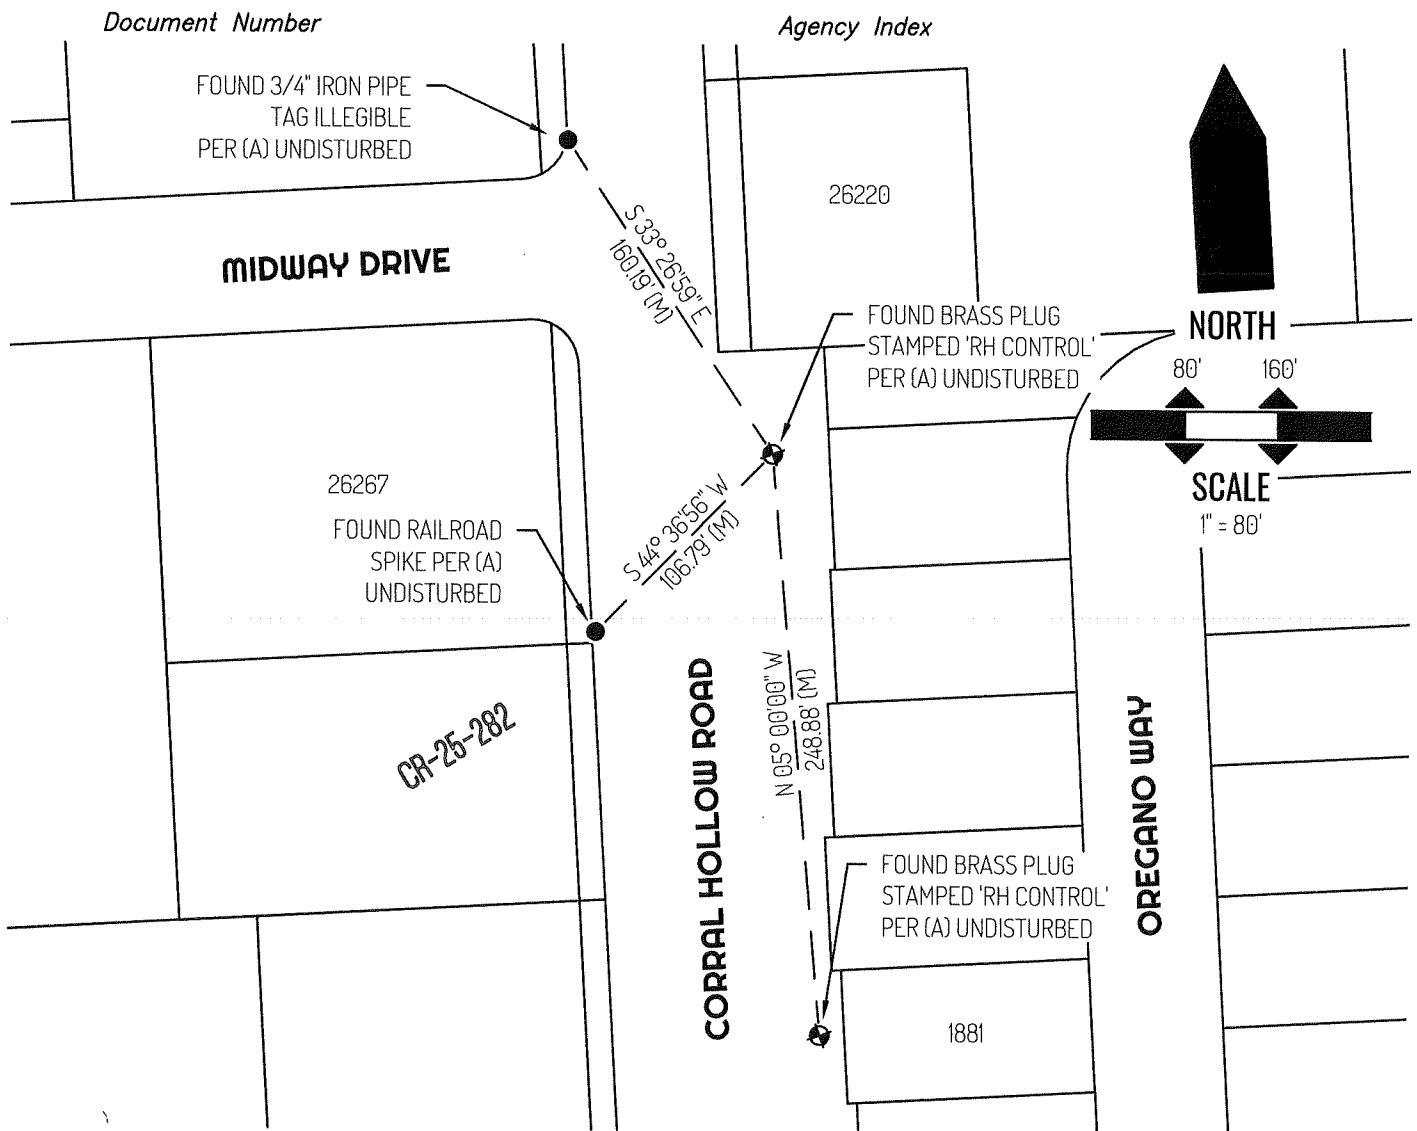

LEGEND

●	FOUND MONUMENT AS NOTED
⊕	FOUND CONTROL POINT AS NOTED
26267	REFERENCE STREET ADDRESS
(M)	MEASURED
CR	CORNER RECORDS, SAN JOAQUIN COUNTY SURVEYOR'S RECORDS
---	TIE LINE
---	LOT LINE

REFERENCE

(A) CORNER RECORD 25-282, SAN JOAQUIN COUNTY SURVEYOR'S RECORDS.