
CORNER RECORD

Agency Index CR-26-294

Document Number

City of STOCKTON County of SAN JOAQUIN, California

Brief Legal Description 33 R.S. 142, S.J.C.R.

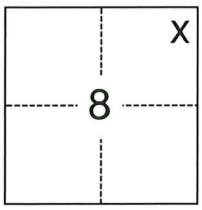

T1N.,R6E., M.D.B.&M

CORNER TYPE

- ☐ Government Corner
- ☐ Meander
- ☐ Rancho
- ☐ Control
- ☒ Property
- ☐ Other

Date of Survey July 9, 2026

COORDINATES (Optional)

N. E.

Elevation

Units ☐ Metric ☒ U.S. Survey Foot

Horizontal Datum

Zone Epoch Date

Vertical Datum

☐ Complies with Public Resources Code §§8801-8819

☐ Complies with Public Resources Code §§8890-8902

PLS Act Ref.:	☐ 8765(d)	☒ 8771	☐ 8773	☐ Other:
Corner/ Monument:	☒ Left as found	☐ Established	☐ Rebuilt	☒ Pre-Construction
	☐ Found and tagged	☐ Reestablished	☒ Referenced	☐ Post-Construction

Narrative of corner identified and monument as found, set, reset, replaced, or removed:

☑ See sheet #2 for description(s):

FOUND 2-1/2" BRASS DISK WITH PUNCH MARK IN A MONUMENT WELL STAMPED "CITY OF STOCKTON SURVEY MONUMENT 8S-8 RCE 14269" PER 33 R.S. 142, SAN JOAQUIN COUNTY RECORDS.

SURVEYOR'S STATEMENT

This Corner Record was prepared by me or under my direction in conformance with the Professional Land Surveyors' Act on August 7, 2026.

Signed Ron Monsour (P.L.S.) or R.C.E. No. 8474



COUNTY SURVEYOR'S STATEMENT

This Corner Record was received August 17, 2026

and examined and filed August 24, 2026

Signed RL Borsdorf III P.L.S. ~~or R.C.E.~~ No. 9728


Title County Surveyor

County Surveyor's Comment



47357104

DOCUMENT NUMBER: AGENCY NUMBER:

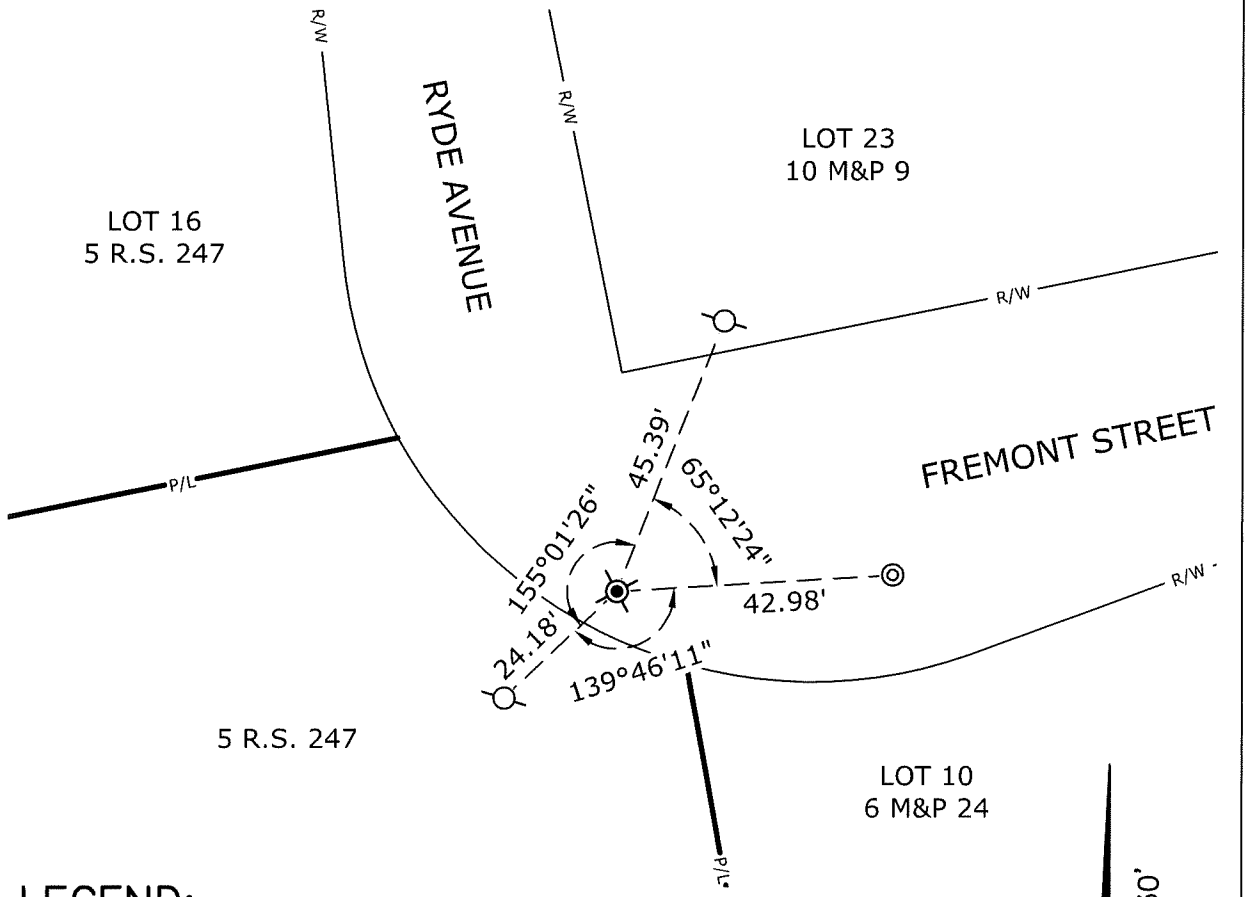

LEGEND:

⊗	FOUND 2-1/2" BRASS DISK WITH PUNCH MARK IN WELL STAMPED "CITY OF STOCKTON SURVEY MONUMENT 8S-8 RCE 14269"
⌀	SET 5/8" X 30" REBAR WITH CAP
◎	SET DIMPLED SPIKE STAMPED "SURVEY MARK"
——R/W——	RIGHT OF WAY
—— P/L ——	PROPERTY LINE
S.J.C.R.	SAN JOAQUIN COUNTY RECORDS
M&P	MAPS & PLATS
R.S.	RECORD OF SURVEY

SCALE : 1"=30'

0' 15' 30'

SCALE: 1"=30'

REFERENCE(S):

33 R.S. 142, S.J.C.R.

NOTE: THE PURPOSE OF THIS CORNER RECORD IS TO PERPETUATE THE POSITION(S) OF EXISTING MONUMENT(S). NO REPRESENTATION IS MADE TO ANY RELATIVE POSITION(S) OF SAID MONUMENT(S). ALL RIGHT OF WAY, PROPERTY LINES, CENTERLINES AND OTHERS ARE FOR GRAPHICAL REPRESENTATION ONLY.

905 Sutter St., Suite 200, Folsom, CA 95630
(916) 366-3040 Fax (916) 366-3303
R. E. Y. ENGINEERS, Inc.
Civil Engineers / Land Surveyors

CORNER RECORD EXHIBIT MAP

SCALE: 1" = 30'	
JOB NO: 47357104	
DATE: 8/7/2026	
DWG: 47357104.dwg	