8/18/26


CORNER RECORD

Agency Index CR-26-298

Document Number

City of Stockton County of San Joaquin, California

Brief Legal Description Lot 119, per M.&P. 30-62, S.J.C.R.

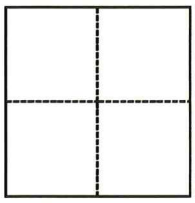

CORNER TYPE

- ☐ Government Corner
- ☐ Meander
- ☐ Rancho
- ☐ Control
- ☒ Property
- ☐ Other

Date of Survey July 23, 2026

COORDINATES (Optional)

N. E.

Elevation

Units ☐ Metric ☐ U.S. Survey Foot

Horizontal Datum

Zone Epoch Date

Vertical Datum

☐ Complies with Public Resources Code §§8801-8819

☐ Complies with Public Resources Code §§8890-8902

PLS Act Ref.:	☐ 8765(d)	☒ 8771	☐ 8773	☐ Other:
Corner/ Monument:	☐ Left as found	☐ Established	☐ Rebuilt	☐ Pre-Construction
	☐ Found and tagged	☒ Reestablished	☐ Referenced	☐ Post-Construction

Narrative of corner identified and monument as found, set, reset, replaced, or removed:

☑ See sheet #2 for description(s):

SURVEYOR'S STATEMENT

This Corner Record was prepared by me or under my direction in conformance with the Professional Land Surveyors' Act on August 13, 2026.

Signed [signature] P.L.S. or R.C.E. No. 7269

LICENSED LAND SURVEYOR JOE MURPHY No. 7269 EXP. 12-31-26 STATE OF CALIFORNIA 8-13-26

COUNTY SURVEYOR'S STATEMENT

This Corner Record was received August 18, 2026

and examined and filed September 12, 2026.

Signed RLB III P.L.S. or ~~R.C.E.~~ No. 9728


Title County Surveyor

County Surveyor's Comment

PROFESSIONAL LAND SURVEYOR ROBERT L. BORSDORF III LICENSE No. 9728 STATE OF CALIFORNIA

Document Number

Agency Index

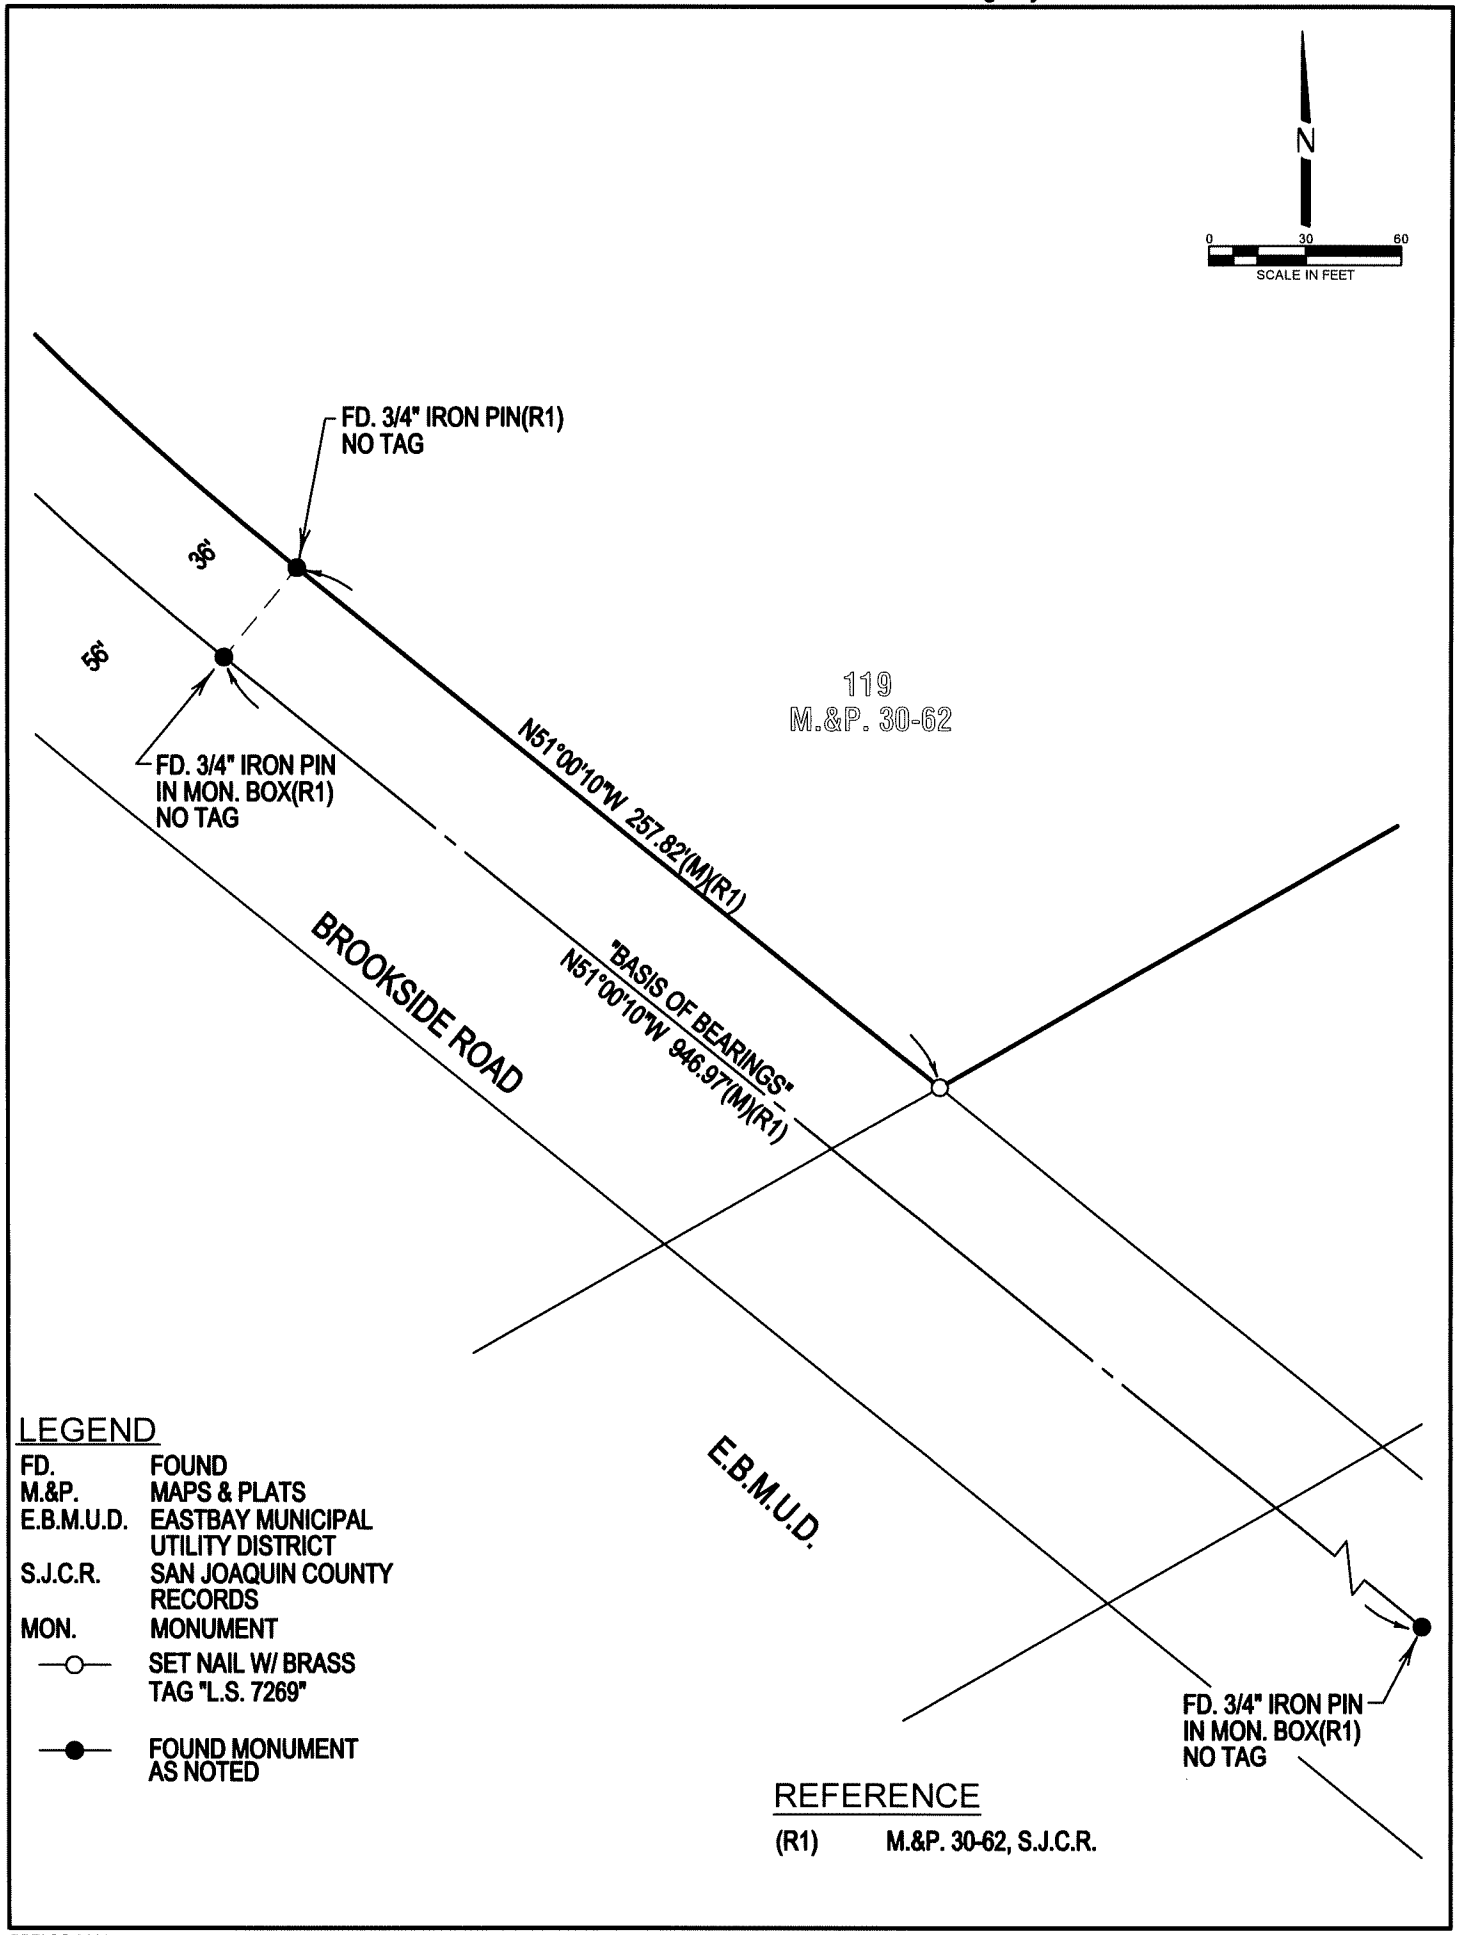

LEGEND

FD.	FOUND
M.&P.	MAPS & PLATS
E.B.M.U.D.	EASTBAY MUNICIPAL UTILITY DISTRICT
S.J.C.R.	SAN JOAQUIN COUNTY RECORDS
MON.	MONUMENT
—○—	SET NAIL W/ BRASS TAG "L.S. 7269"
—●—	FOUND MONUMENT AS NOTED

REFERENCE

(R1) M.&P. 30-62, S.J.C.R.

S:\2026\2679\Boundary_Topo_072326.dwg Aug 13, 2026

BPELSG-2016