
CORNER RECORD

Agency Index CR-26-302

Document Number

City of Stockton County of San Joaquin, California

Brief Legal Description Sacramento Street South of Eighth Street

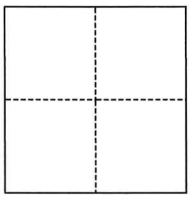

CORNER TYPE

- ☐ Government Corner
- ☐ Control
- ☐ Meander
- ☒ Property
- ☐ Rancho
- ☐ Other

Date of Survey February 4, 2026

COORDINATES (Optional)

N. E.

Elevation

Units ☐ Metric ☐ U.S. Survey Foot

Horizontal Datum

Zone Epoch Date

Vertical Datum

☐ Complies with Public Resources Code §§8801-8819

☐ Complies with Public Resources Code §§8890-8902

PLS Act Ref.:	☐ 8765(d)	☒ 8771	☐ 8773	☐ Other:
Corner/ Monument:	☒ Left as found	☐ Established	☐ Rebuilt	☒ Pre-Construction
	☐ Found and tagged	☐ Reestablished	☒ Referenced	☐ Post-Construction

Narrative of corner identified and monument as found, set, reset, replaced, or removed:

☑ See sheet #2 for description(s):

SURVEYOR'S STATEMENT

This Corner Record was prepared by me or under my direction in conformance with the Professional Land Surveyors' Act on February 6, 2026.

Signed _____ P.L.S. or R.C.E. No. PLS 7889

PROFESSIONAL LAND SURVEYOR ★ JOSHUA COOK ELSON ★ L 7889 ★ STATE OF CALIFORNIA ★

COUNTY SURVEYOR'S STATEMENT

This Corner Record was received August 26, 2026

and examined and filed September 17, 2026.

Signed RLB III P.L.S. ~~or R.C.E. No.~~ 9728

Title County Surveyor

County Surveyor's Comment

PROFESSIONAL LAND SURVEYOR ★ ROBERT L. BORSDORF III ★ LICENSE No. 9728 ★ STATE OF CALIFORNIA

Document Number

Agency Index

LEGEND:

M&P MAPS AND PLATS, BOOK AND PAGE, SAN JOAQUIN COUNTY RECORDS

CR CORNER RECORD, SAN JOAQUIN COUNTY SURVEYOR'S RECORDS


SFN SEARCHED, FOUND NOTHING

FOUND 1.25" DIAMETER BRASS DISK STAMPED "PLS 8489 RH", UNLESS OTHERWISE NOTED

FOUND 3/4" IRON ROD TAGGED "RCE 8189" IN MONUMENT WELL

DESCRIPTION:

THIS CORNER RECORD IS FOR THE PURPOSE OF MONUMENT PRESERVATION. REFERENCES WERE FOUND AND/OR SET FOR FOUND MONUMENTS AS NOTED ON DIAGRAM. NO BOUNDARY ANALYSIS WAS PERFORMED. THIS CORNER RECORD DOES NOT VERIFY THE MONUMENT(S) TO BE IN THE CORRECT POSITION.

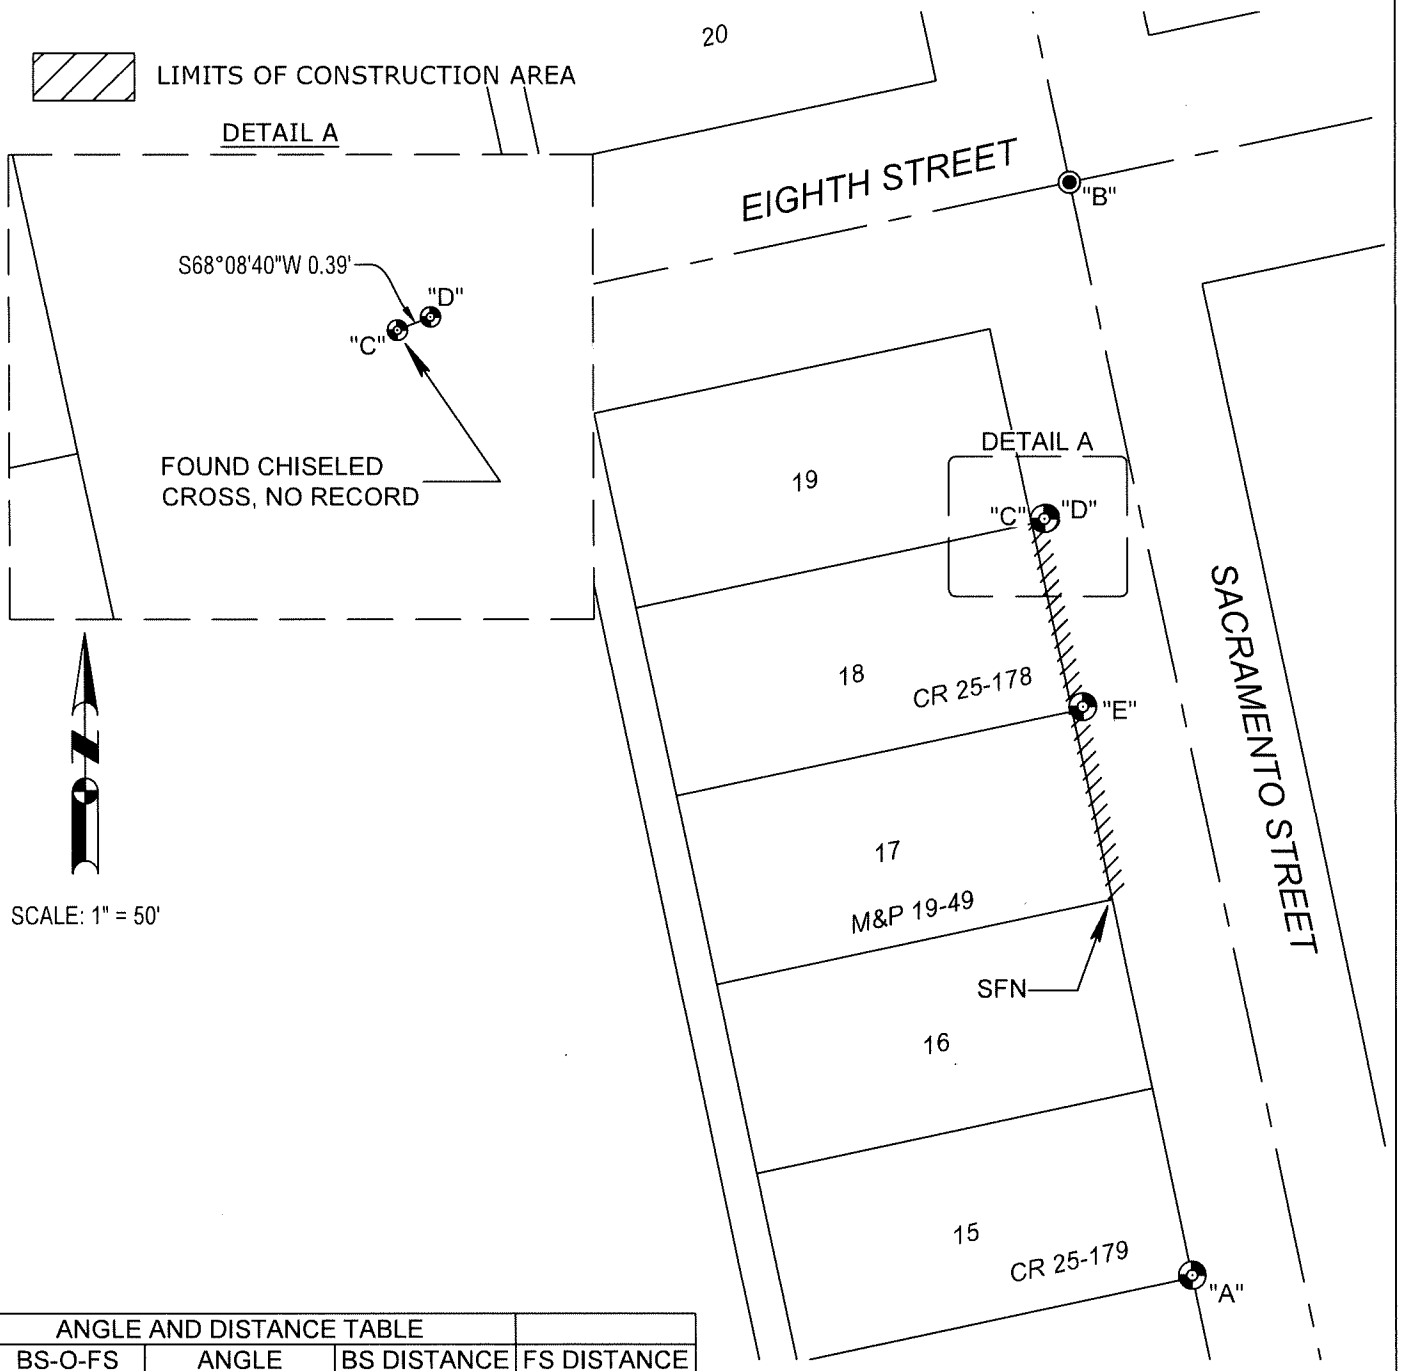

ANGLE AND DISTANCE TABLE			
BS-O-FS	ANGLE	BS DISTANCE	FS DISTANCE
A-C-B	164°39'34"	212.37'	93.29'
A-D-B	164°58'47"	212.44'	93.12'
A-E-B	170°27'40"	159.35'	145.05'

KJELDSEN SINNOCK NEUDECK
CIVIL ENGINEERS & LAND SURVEYORS